

U.S. PUBLIC LAND SURVEY MONUMENT RECORD


Note: This form is intended and designed to fulfill all requirements of Wisconsin Administrative Code, Chapter A-E 5.02, U.S. Public Land Survey Monument Record (3) (a) (b) (c) (d) (e) (f) (g) (h) (i). An additional sheet may be added if necessary to conform with said requirements.

(a) Corner location: Township 36 North

Range 7 East/West

Town/City/Village Woodboro

County Oneida

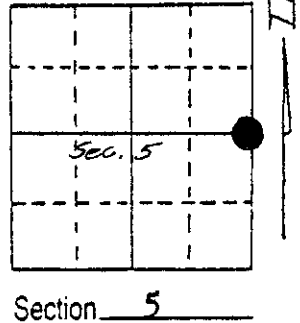

Section 5

(b) (f) (g) (h) Description of monument found at this corner and if it was accepted, state all evidence (material, testimonial, occupational, plats, records, other monuments) used as a basis for accepting. If not accepted or if nothing was found, state evidence used as basis for establishing location. If reestablished through lost corner proportionate methods, indicate all monuments, distances and directions used to establish.



Original Survey in 1862 by Joseph H. Jenkins. South corrected 52.80 Chains, Set post: Tam. 10, S8E, 12 lks.; Y. Pine 20, S61 W., 60 lks. South 2.01 Ch. intersect lake and set meander post.

Survey by John Fisher in 1975. He found corner marked by 1 1/2 inch Iron Pipe. Set Railroad Spikes in N. Pine 12", S54E, 10.8 Ft. and in Power Pole #3607-5E13, S22W, 13.2 ft.

In 1981 I found Fishers References and 2 pieces of Iron Pipe along side of each other. On May 5, 1987 I recovered the 2 pieces of iron pipe and the railroad spikes. The power pole had been cut off and was being used for a Utility pole, a new pole was set N.74 W, 3.2 ft. from old pole. The Number had been transferred to the new pole.

I replaced the iron pipe with a 30 inch long Oneida County Aluminum Monument with cap, stamped to identify corner and set white witness post 6 inches, SW of monument. I made 3 new reference ties by placing Cement Nails in the side of 2 Norway Pine and the new power pole.

(c) (d) (e) Plan view of corner with ties to at least 4 witness monuments. If in disagreement with previously established corner, show the distances between the two corners and also indicate the ties to the disputed corner.

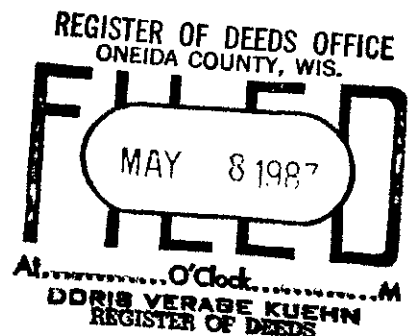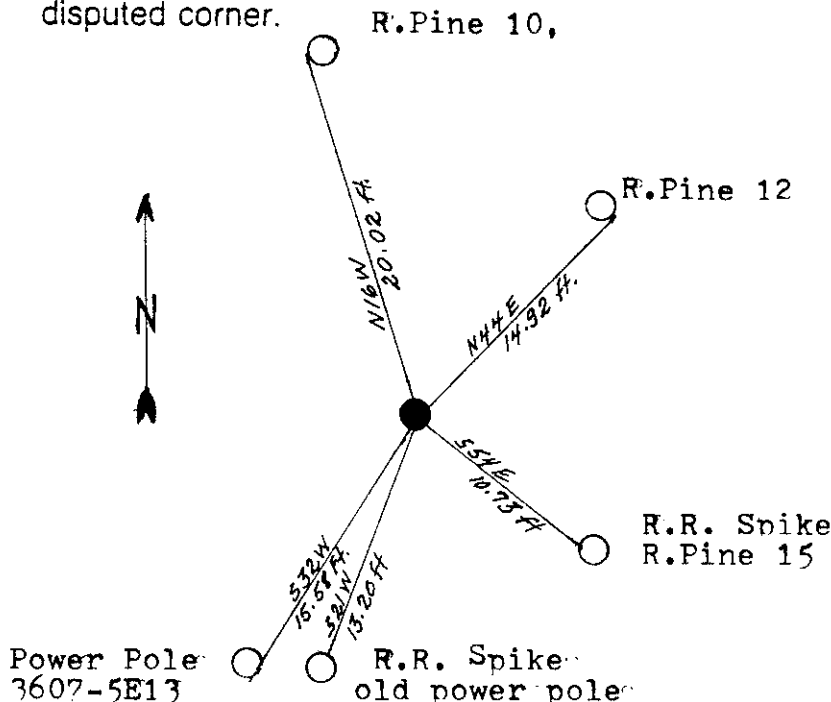

(i) I, Jean F. Resvick
 (type or print name) certify that the corner location on this record was determined by me or under my direction and control and that this U.S. Public Land Survey Monument Record is correct and complete to the best of my knowledge and belief.

Jean F. Resvick Signature May 5, 1987 Date



Index No. 6-9

3607052000