

U.S. PUBLIC LAND SURVEY MONUMENT LOCATION RECORD

Recorders Data

USPLS CORNER: EAST WITNESS MC SECTION: 17 TOWNSHIP: 36 NORTH RANGE: 08 EAST

NAME OF WATERWAY FOR M.C. CORNER : CRESCENT LAKE SECTION LINE: NORTH

~~(CITY)(VILLAGE)(TOWN)~~ OF: CRESCENT COUNTY OF: ONEIDA

Description of monument found or placed and all other evidence used as the basis for monument location; including monuments and related measurements required if the corner location was reestablished by lost corner proportionate methods. Also indicate name of original surveyor, original survey date and the corner monument, bearing trees, witness or other reference monuments established; including measured bearing and distance ties, from available records.

Found and accepted an old rusted 1" dia. by 18" long iron pipe monument with uncapped top flush with existing lawn grade at the N1/16NE forty corner per record survey plat filed as A-221 in Oneida County survey records, which I carefully pulled and reset with a standard 2" dia. by 30" long aluminum pipe monument with stamped Oneida County cap 1" below lawn grade; said monument set also to serve as this East Witness MC per approval of Oneida County Surveyor Michael Romportl. No standard white poly 'T' marker post set near corner as it would be in lawn area.


In July 1863, William E. Daugherty/GLO set a wood post as the original corner and marked new OBTs: a 15" Bw N75°W 26 links and a 10" Hemlock S86°E 14 links, all of which are now obliterated about 24' West of this corner location.

In 1940, V.M. Maine notes a buried Oak post at this corner location and marked BTs: a 14" Pw N26.75°W 46.4 links and a 12" Pw S19°E 25 links per Plat of Survey filed as A-118 in Oneida County survey records; all of which are now gone or obliterated.

In September 1947, F. Wincentsen/RLS 155, notes an iron pipe at this corner and new BTs: a 24" Pw N30°W 17' and a 12" Pn S29°W 19.2', per Plat of Survey filed as A-221 in Oneida County survey records; all found OK this date. He also noted an iron pipewith BTs as an MC 23.7' West of this forty corner location, all of which are now gone.

This recovery completed June 6, 2000; there were no direct witnesses. I also referred to 1970 Herbert Moore/RLS CSM No. 41 filed in Oneida County records; two(2) monuments of which I used for new ties indicated below.

Plan view map of monument location with bearing and distance ties to a minimum of four(4) described witness or reference monuments of concrete, natural stone, iron, live bearing trees or equivalent material. If applicable, also show a minimum of two(2) bearing and distance ties to any other monument found and not accepted; including the bearing and distance from the accepted monument.

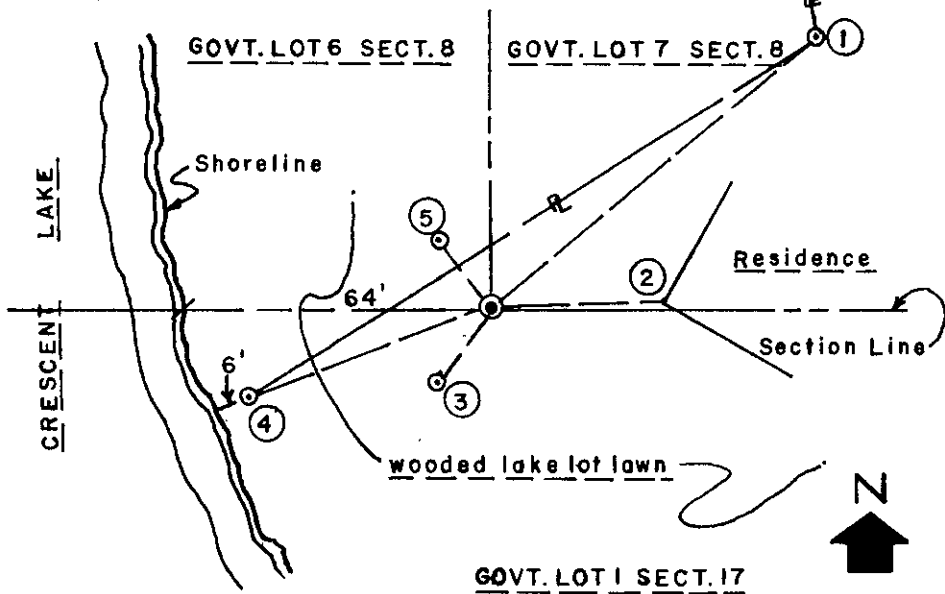


WITNESS MONUMENT TIES:

- ① Old 1" dia. iron pipe found with uncapped top 1" below lawn grade N50°E 89.50'.
- ② New witness SW corner of block residence foundation N88°E 35.93'.
- ③ Old BT 18" Pr with plain blaze scar on face at root crown S35°W 19.35'.
- ④ Old 3/4" dia. iron pipe found bent S69°W 54.85', which I reset with old 1" dia. by 18" iron pipe I had pulled at this 40 Corner location.
- ⑤ Old BT 32" Pw with face blazes shut and faint N40°W 17.83'.

SCALE: 1" = 40'

Unless otherwise indicated, all bearing tree ties are to a .25" dia. by 2.5" long PK nail with a 1.25" dia. steel washer driven into unblazed right face and a .25" dia. by 2.5" long PK nail with a 2" dia. steel washer stamped BT is also driven into unblazed face of bearing tree at DBH; the basis for measured bearings is by compass to nearest degree and all tie distances are measured horizontal by steel tape corrected to nearest 1/100th feet at standard temperature of 68° F.

RLS SEAL:

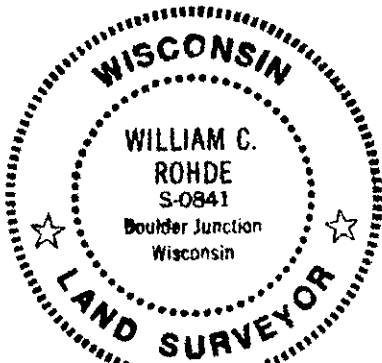


LAND SURVEYOR CERTIFICATE:

I, William C. Rohde, hereby certify that I am duly licensed as a Professional Land Surveyor in the State of Wisconsin; that this USPLS monument location was determined by me and/or under my direct supervision and control; and that this U.S. Public Land Survey Monument Location Record is true and correct to the best of my knowledge and belief.

Signed: *William C. Rohde*  
William C. Rohde RLS 841

Date Signed: August 24, 2000

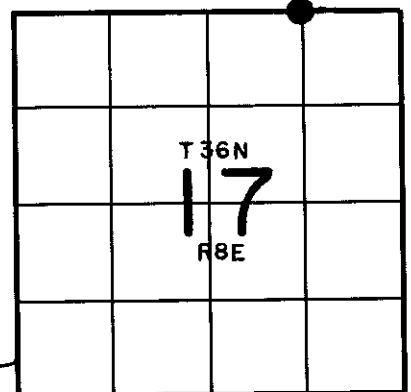


SECTION LOCATION MAP  
INDEX NO. J 8

# U.S. PUBLIC LAND SURVEY MONUMENT RECORD

Note: This form is intended and designed to fulfill all requirements of Wisconsin Administrative Code, Chapter A-E 7.08 U.S. Public Land Survey Monument Record (3)(a-i).

(a) CORNER LOCATION  
 Wit. Meander Cor. of Secs. 8 & 17  
 Township 36 North  
 Range 8 East of the 4th P.M.  
 Town of Crescent  
 County of Oneida

WISCRS - Oneida County  
 N: 155,876.97 USft  
 E: 237,166.65 USft  
 Datum: NAD 83(2011) ep. 2010.00  
 GNSS Method: RTN - Offset  
 GNSS Control: WISCORS VRS

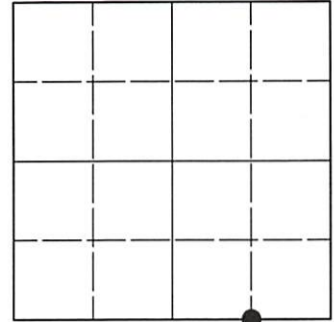

Sec. 8, T. 36 N., R. 8 E.

(b)(f)(g)(h) Description of monument found at this corner and if it was accepted, state all evidence (material, testimonial, occupational, plats, records, other monuments) used as a basis for accepting. If not accepted or if nothing was found, state evidence used as basis for establishing location. If re-established through lost corner proportionate methods, indicate all monuments, distances and directions used to establish. Indicate type of monument and sign post found or set.

*This record is a perpetuation of the following land corner document(s):*


*August 24, 2000: USPLS Monument Record by William C. Rohde, filed in Oneida County*

*A complete history of the corner can be found on the previous land corner document(s). I accept the record activity as a true and faithful perpetuation or reestablishment of the original corner location and further perpetuate it as described below.*

*May 16, 2022: I found and accepted the record monument, a 2.4" diam. aluminum pipe, firmly set, with a 3.3" diam. Oneida Co. aluminum cap in a landscaped area around a small spruce. I found or established accessories as indicated below. As the corner is in a residential yard, I did not set a sign post.*

*The coordinate value shown has been determined by traversing from two or more GNSS offset points satisfying the accuracy requirements defined and qualified in the 2022 Oneida County Fee Schedule for USPLS Corners.*

(c)(d)(e) Plan view of corner with ties to at least 4 witness monuments. If in disagreement with previously established corner, show the distances between the two corners and also indicate the ties to the disputed.

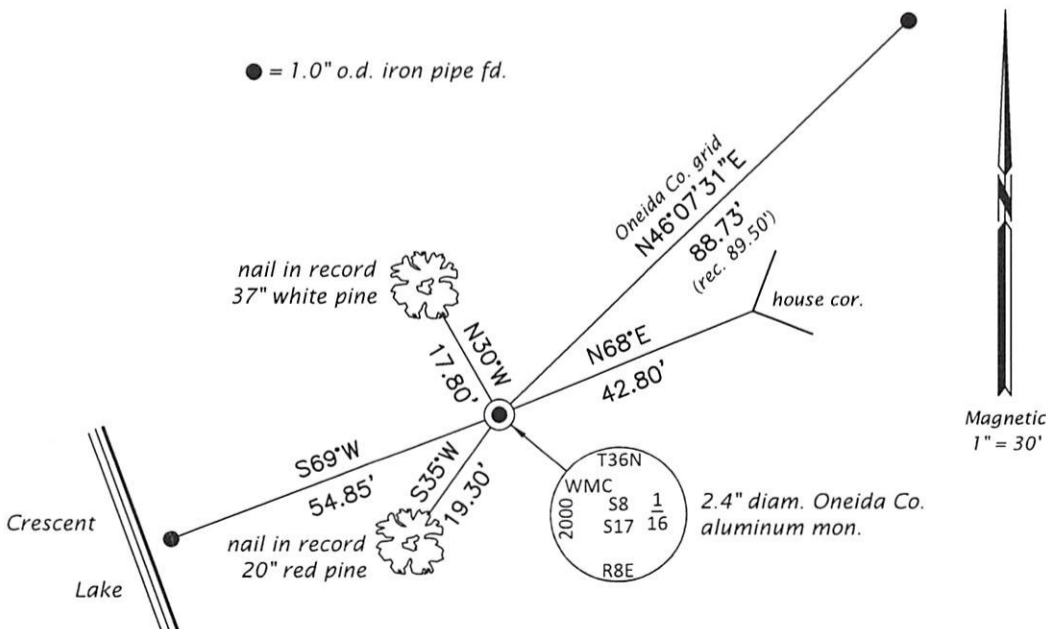


REGISTER OF DEEDS OFFICE  
 ONEIDA COUNTY  
 FILED

AUG 02 2022

KYLE J. FRANSON  
 REGISTER OF DEEDS

(i) I, Jeffrey W. Austin, Professional Land Surveyor No. S-1885, hereby certify that the corner location on this record was determined by me or under my direction and control and that this U.S. Public Land Survey Monument Record is correct and complete to the best of my knowledge and belief.

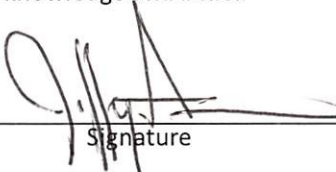  
 Signature JUNE 1, 2022  
Date