

Ch

This form is intended to fulfill the requirements of Chapter A-E 7.08 (3)(a) thru (i) U.S. Public Land Survey Monument Location Record, Wisconsin Administrative Code. Use the reverse side of form for continuation.

U.S. PUBLIC LAND SURVEY MONUMENT LOCATION

Recorders Data

USPLS CORNER: NW SECTION SECTION: 27 TOWNSHIP: 36 NORTH RANGE: 08 EAST

NAME OF WATERWAY FOR M.C. CORNER : N/A SECTION LINE: N/A

~~(CITY)(VILLAGE)~~(TOWN) OF: CRESCENT COUNTY OF: ONEIDA

Description of monument found or placed and all other evidence used as the basis for monument location; including monuments and related measurements required if the corner location was reestablished by lost corner proportionate methods. Also indicate name of original surveyor, original survey date and the corner monument, bearing trees, witness or other reference monuments established; including measured bearing and distance ties, from available records.

THIS CORNER REREFERENCED WITH APPROVAL OF ONEIDA COUNTY SURVEYOR MICHAEL ROMPORTL DUE TO INADEQUATE REMAINING REFERENCES OF USPLS LOCATION RECORD BY WILLIAM G. IMMICH/RLS 1383 FILED NOVEMBER 8, 1984.

Found and accepted a standard 6" dia. concrete monument with stamped GLO brass tablet in top 10" below the south edge of existing blacktop roadway pavement. This recovery completed June 28, 2000; there were no direct witnesses.


In 1939 during a GLO resurvey, Hal D. Craig and Lester S. Mann set the foregoing GLO monument and marked new BTs: A 6" Oak N23.75°E 70 links, now a 14" Oak with no visible markings but used for new ties; a 6" Oak S40.5°W 17 links, now a 20" Oak S25°W with no visible markings and a 12" Poplar N16°W 140 links, now obliterated.

In March 1968, Norman J. Loftus/RLS 259 noted GLO capped monument found per Plat of Survey filed as B-2506 in Oneida County records.

In 1974, during a GLO resurvey, Ronald J. Eberis found the 1939 GLO resurvey monument and BTs, 10" Oak NE and 11" Oak SW at record distances and bearings.

In May 1995, Todd J. Loftus/RLS 1523 noted GLO monument found at this corner per Plat of Survey filed as B-3194 in Oneida County records.


Plan view map of monument location with bearing and distance ties to a minimum of four(4) described witness or reference monuments of concrete, natural stone, iron, live bearing trees or equivalent material. If applicable, also show a minimum of two(2) bearing and distance ties to any other monument found and not accepted; including the bearing and distance from the accepted monument.

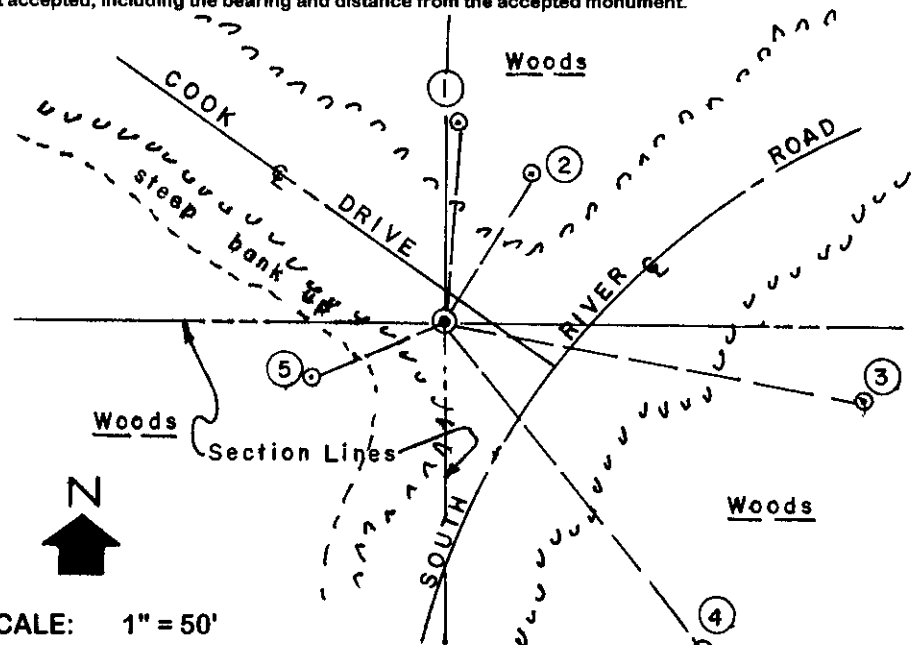

- WITNESS MONUMENT TIES:**
- ① New BT 12" Maple/South trunk of 3 at N04°E 52.54'.
 - ② Old BT 14" Oak N29°E 44.76' to old 60d spike in right face.
 - ③ New BT 7" Pw S79°E 110.83'.
 - ④ New BT 12" Pr S38°E 110.06'.
 - ⑤ New BT 7" Pw S68°W 38.40'.
- See 1984 location record for ties I found OK to power pole and SW oak BT.
Standard white poly 'T' marker post set 5.0' South of corner monument and about 1' West of Stop sign.


SCALE: 1" = 50'

Unless otherwise indicated, all bearing tree ties are to a .25" dia. by 2.5" long PK nail with a 1.25" dia. steel washer driven into unblazed right face and a .25" dia. by 2.5" long PK nail with a 2" dia. steel washer stamped BT is also driven into unblazed face of bearing tree at DBH; the basis for measured bearings is by compass to nearest degree and all tie distances are measured horizontal by steel tape corrected to nearest 1/100th feet at standard temperature of 68° F.

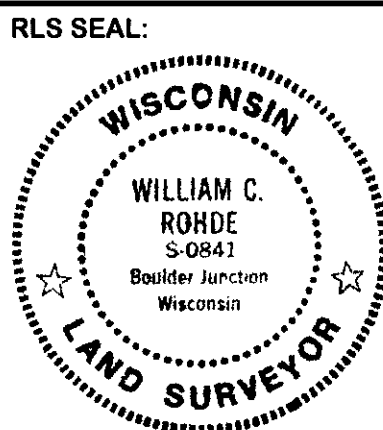

LAND SURVEYOR CERTIFICATE:
I, William C. Rohde, hereby certify that I am duly licensed as a Professional Land Surveyor in the State of Wisconsin; that this USPLS monument location was determined by me and/or under my direct supervision and control; and that this U.S. Public Land Survey Monument Location Record is true and correct to the best of my knowledge and belief.

Signed: *William C. Rohde*
William C. Rohde RLS 841

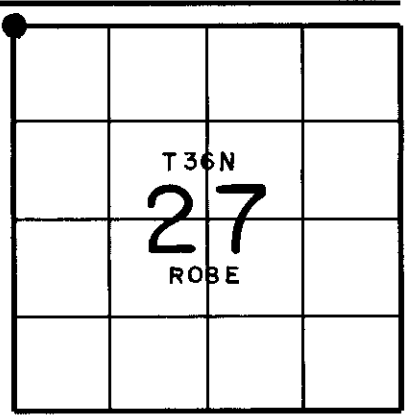

Date Signed: January 31, 2001

SECTION LOCATION MAP
INDEX NO. _____
3608210000

U S PUBLIC LAND SURVEY MONUMENT RECORD

NOTE: This form is intended and designed to fulfill all requirements of Wisconsin Administrative Code, Chapter A-E 7.08 U.S. Public Land Survey Monument Record (3) (a-i)

A-E 7.08(3)(a) Identity of corner
 SOUTHEAST CORNER SECTION 21
 TOWNSHIP 36 NORTH
 RANGE 08 EAST OF THE 4TH PM
 TOWN OF CRESCENT
 COUNTY OF ONEIDA

WISCORS - ONEIDA COUNTY
 N: 145,235.802 USft
 E: 244,066.314 USft
 Datum: NAD83 (2011)
 GNSS Method RTN - Direct
 GNSS Control WISCORS VRS



The coordinate value shown has been verified by the average of two or more GPS observations at a markedly different time.

A-E 7.08(3)(b) Description of any record evidence, monument evidence, occupational evidence, testimonial evidence, or any other material evidence.

Original Surveyor: William Daugherty

REGISTER OF DEEDS OFFICE
 ONEIDA COUNTY
 FILED

Date of Original Survey Commenced: July 06, 1863
 Completed: July 16, 1863

APR 21 2022

Original Accessories:

See Previous Monument Record:
 R-13

Birch 15 N. 26° W. 19 links
 Birch 12 S. 47° E. 13 links

KYLE J. FRANSON
 REGISTER OF DEEDS

September - October, 1939 - Surveyor - Hal D. Craig - Set a concrete monument 24" long, 6" dia., 6" below the surface of the road, with a brass tablet 3.5" dia. marked.
 Craig made new bearing trees: Red Oak, 6" - N.23 3/4° E., 70 lks., Red Oak, 6" - S.40 1/2°W., 17 lks., and Poplar, 12" N.16°W., 140 lks.
 March, 1968 - Surveyor 00259 - Norman J. Loftus - Notes corner - Oneida Co. Map B2506
 May, 1974 - Cadastral Surveyor - Ronald J. Eberle - Finds Hal D. Craig's 6" diam. concrete monument, 6" below road surface, with brass cap makd. - Oneida Co. Map L356
 November, 1984 - Surveyor 1383 - William Immich - USPLS Location Record (per William Rhode).
 May, 1995 - Surveyor 1523 - Todd J. Loftus - Found "GLO Mon." - Oneida Co. Map B3194
 May, 1999 - Surveyor 2148 - Russell F. Brown - Found "Brass Capped Iron Pipe" - Oneida Co. Map C1587
 June, 2000 - Surveyor 0841 - William C. Rhode - Found "standard 6" dia. concrete monument with stamped GLO Brass tablet. USPLS Monument Location Record R-13.
 June, 2007 - Surveyor 2118 - Michael L. Oestreich - Recovered GLO brass capped 2.4" dia. iron pipe in the southerly shoulder of Cook Drive, and made new ties as shown on Survey Landmark Preservation Record - Oneida Co. Map L2479


A-E 7.08(3)(f) Whether the corner was restored through acceptance of an obliterated location or a found perpetuated location.

November 01, 2021 - I found a 6" diameter concrete monument with a 3" diameter brass cap stamped to identify corner location. Monument is ±10" below road surface. I set a railroad spike 2" below road surface and directly above the found monument.


I also found all of Rhode's witnesses intact as shown below. I did not measure to the witnesses.

I accept this monument as a FOUND PERPETUATED LOCATION OF THE CORNER and established new witnesses as shown below.

A-E 7.08(3)(c)(d)(e)(h) Plan view of corner with references to at least 4 witness monuments. If in disagreement with previously established corner, show the distances between the two corners and also indicate the ties to the disputed. The directions and distances to other public land survey corners used as evidence or used for determining the corner location.

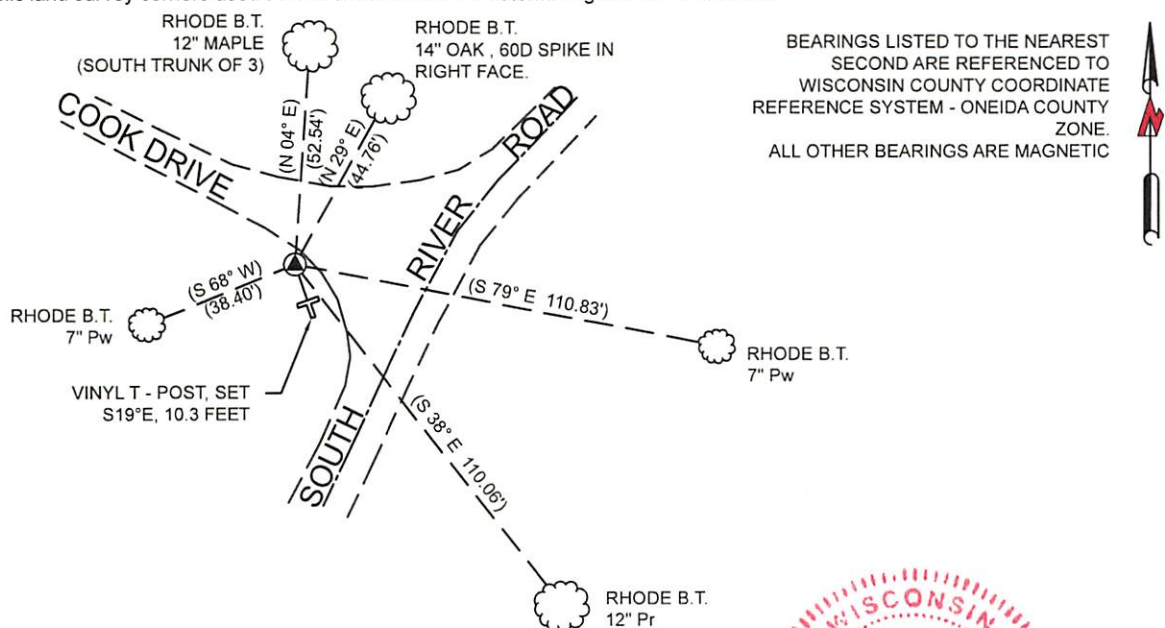

A-E 7.08(3)(i) I, Jeffrey L. DeMuth, Professional Land Surveyor No. S-2656, hereby certify that the corner location on this record was determined by me or under my direction and control and that this U.S. Public Land Survey Monument Record is correct and complete to the best of my knowledge, and belief

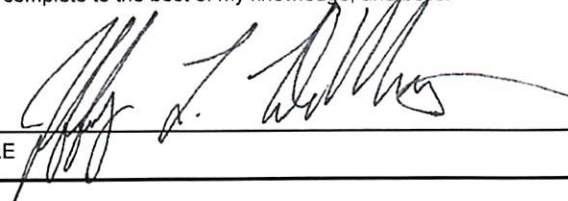SIGNATURE  DATE March 28, 2022

