

2025
7/11/14

U. S. PUBLIC LAND SURVEY MONUMENT RECORD


INSTRUCTIONS: This record shall show the location of the corner and shall include all of the following nine elements (a through i).

(a) Identify the corner by reference to the U.S. public land survey system.

○ = Corner monument restored.

S.W. COR. SEC. 30, TOWNSHIP 36 NORTH, RANGE 9 EAST, ONEIDA COUNTY, WISCONSIN

- 1859 Hiram Fellows established orig. cor.
- 1894 B. F. Dorr at corner gray boulder
- 1915 D.H. Vaughan recovered Dorrs boulder and corrected line north for rd. He set a 2"x30" iron pipe with reference pipes 25' east & west of corner.
- N. J. Loftus found iron pipe in road B.T.s N. Pine 8 S 12 W 38 lks.; Basswood 15 S 72 E 823/4 lks. Ref. pipe 50 lks. East

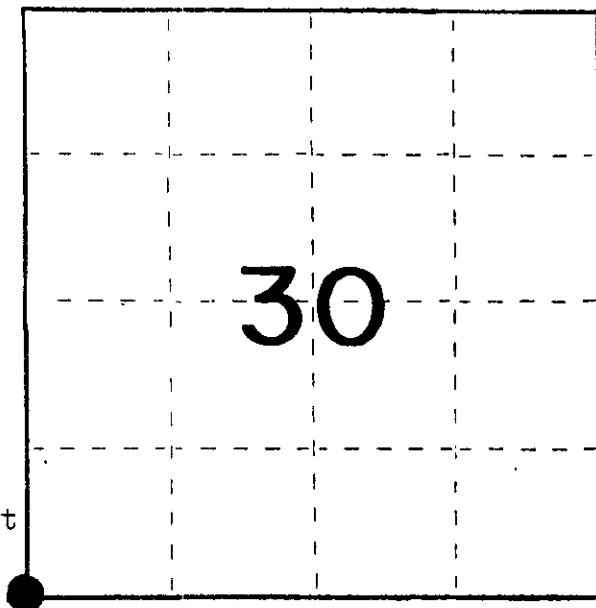



(b) Describe any record evidence, monument evidence, occupational evidence, testimonial evidence or any other material evidence you considered, and whether the monument was found or placed.

-at this corner I found a 2" iron pipe in road and Loftus B.T. After the road was constructed I set a Oneida county monument and witnessed it as shown below.

- no evidence of orig. B.T.s found

(c) In the plan view drawing below, provide reference ties to at least 4 witness monuments, or, if the location is within a municipality, to at least 2 witness monuments. (Witness monuments shall be made of concrete, natural stone, iron or other equally durable material.) Describe witness monuments.

(d) Show a plan view drawing depicting the relevant monuments and reference ties which is sufficient in detail to enable accurate relocation of the corner monument if the corner monument is disturbed. Indicate north.

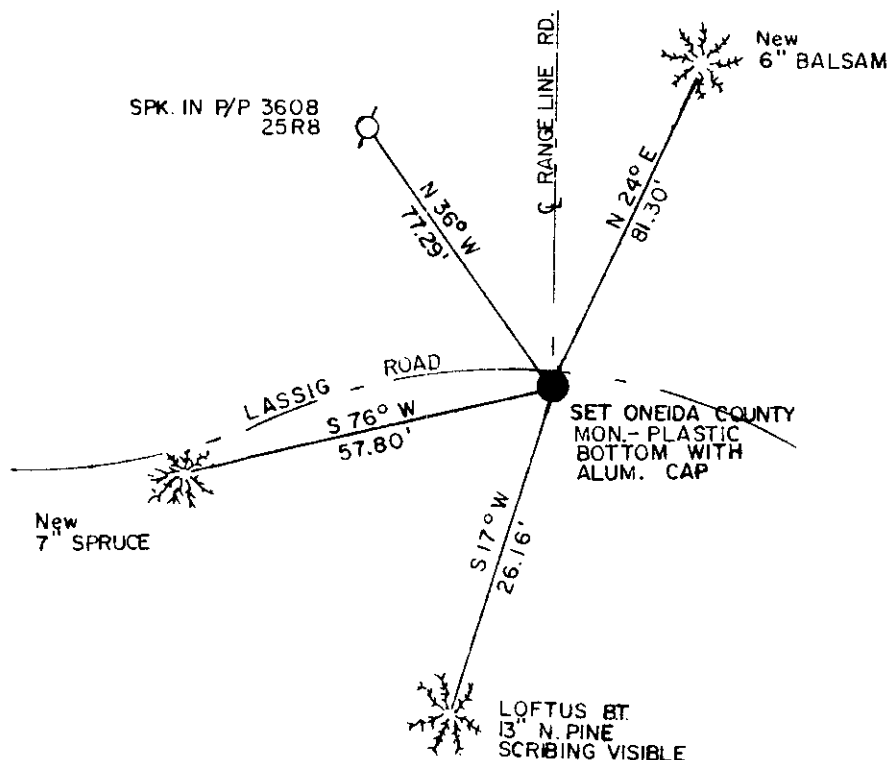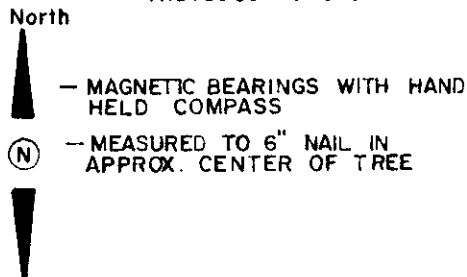

3608250000

1-1

(e) Describe any material discrepancy between the location of the corner as restored or reestablished and the location of that corner as previously restored or reestablished by distance and direction. Show the discrepancy on the plan view drawing under (d), above. Show the distances between the corner as previously restored or reestablished and (1) the corner as restored or reestablished, and (2) to at least 2 of the witness monuments shown on the drawing in (d), above.


none found

(f) Was the corner restored through acceptance of (1) an obliterated evidence location, or, (2) a found perpetuated location?


a found perpetuated location

(g&h) Was the corner reestablished through lost corner proportionate methods? If so, show the method, including the directions and distances to other public land survey corners used as evidence or used for proportioning in determining the corner location?

n/a

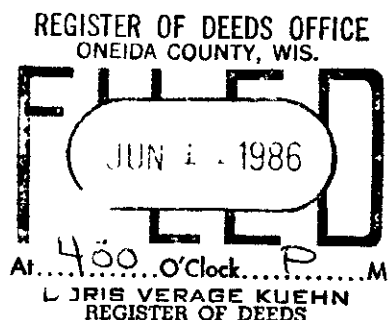

(1) I, MICHAEL J. ROMPORTL
(type or print name) certify that the corner location shown on this record was determined by me or under my direction and control and that this U.S. Public Land Survey Monument Record is correct and complete to the best of my knowledge and belief.

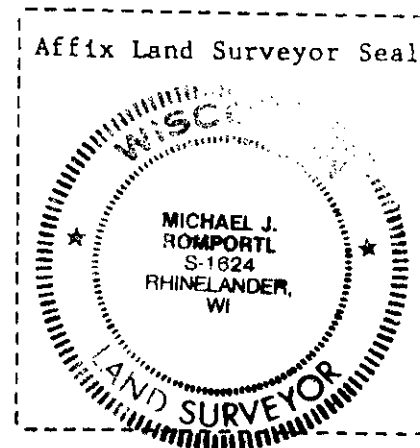

Michael J. Romportl
Signature
GENISOT & ASSOCIATES, INC
1512 N. EAGLE ST.
RHINELANDER, WIS.


October 24, 1984
Date

U.S. PUBLIC LAND SURVEY MONUMENT RECORD

Note: This form is intended and designed to fulfill all requirements of Wisconsin Administrative Code, Chapter A-E 7.08 U.S. Public Land Survey Monument Record (3)(a-i).

(a) CORNER LOCATION
 Cor. of Secs. 25, 30, 31 & 36
 Township 36 North
 Range 8 & 9 East of the 4th P.M.
 Town of Crescent & Pelican
 County of Oneida

WISCRS - Oneida County
 N: 140,031.47 USft
 E: 259,415.81 USft
 Datum: NAD 83(2011)
 GNSS Method: RTN - Direct
 GNSS Control: WISCORS VRS

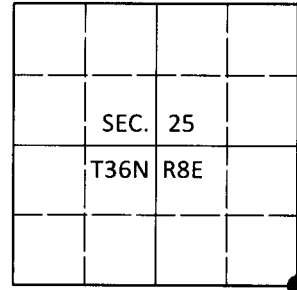

(b) HISTORY OF ORIGINAL CORNER ESTABLISHMENT

Original Surveyor: _____ Original Accessories: _____
 Date of Survey Commenced: _____ See previous monument record(s)
 Completed: _____

(b)(f)(g)(h) Description of monument found at this corner and if it was accepted, state all evidence (material, testimonial, occupational, plats, records, other monuments) used as a basis for accepting. If not accepted or if nothing was found, state evidence used as basis for establishing location. If re-established through lost corner proportionate methods, indicate all monuments, distances and directions used to establish. Indicate type of monument and sign post found or set.


This is a perpetuation of the following monument record(s) that comprise a complete history of the corner:

Oct. 24, 1984: USPLS Monument Record No. 3608250000 by Michael J. Romportl, PLS

Sep. 12, 2019: I found and accepted a perpetuation of the record monument, a PK nail in the pavement of Lassig Road. The record bearing tree at S76°W is now a stump. The record bearing tree at N24°E is in decline. I set a cotton picker spindle to replace the PK nail. I found or established accessories as shown below.

The coordinate value shown has been verified by at least one of the following methods: 1) comparison to a previously GPS determined published value; 2) the value is the average of two or more GPS observations at a markedly different time; 3) one or more distances were measured back to the GPS observed corner from temporary GPS observed offset locations.

(c)(d)(e) Plan view of corner with ties to at least 4 witness monuments. If in disagreement with previously established corner, show the distances between the two corners and also indicate the ties to the disputed.

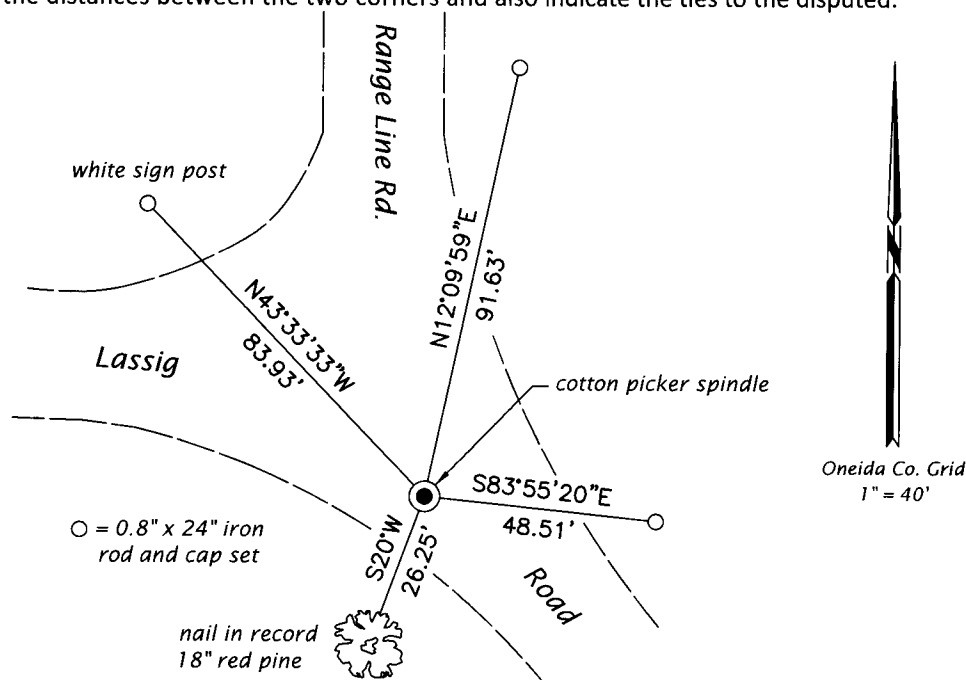

Oneida Co. Grid
 1" = 40'

REGISTER OF DEEDS OFFICE
 ONEIDA COUNTY
 FILED

DEC 23 2019

KYLE J. FRANSON
 REGISTER OF DEEDS

(i) I, Jeffrey W. Austin, Professional Land Surveyor No. S-1885, hereby certify that the corner location on this record was determined by me or under my direction and control and that this U.S. Public Land Survey Monument Record is correct and complete to the best of my knowledge and belief.

[Handwritten Signature]
 Signature

3 DEC 2019
 Date