


U.S. PUBLIC LAND SURVEY MONUMENT RECORD

Note: This form is intended and designed to fulfill all requirements of Wisconsin Administrative Code, Chapter A-E 7.08 U.S. Public Land Survey Monument Record (3) (a) (b) (c) (d) (e) (f) (g) (h) (i). An additional sheet may be added if necessary to conform with said requirements.

(a) Corner location: Township 36 North
 Range 9 East/West

Town/City/Village Pelican Lake
 County Oneida

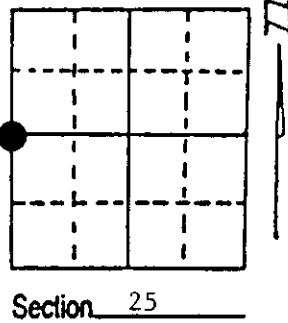

(b) (f) (g) (h) Description of monument found at this corner and if it was accepted, state all evidence (material, testimonial, occupational, plats, records, other monuments) used as a basis for accepting. If not accepted or if nothing was found, state evidence used as basis for establishing location. If reestablished through lost corner proportionate methods, indicate all monuments, distances and directions used to establish. Indicate type of monument found or set and sign post.

1863 - Wm. Daugherty established this corner at 40 Chains and BT:
 6" Birch, N41°E, 267 Links


1/4/1992 - Milo E. Stefan found 1 1/2" iron pipe/3" x 3" x 1/4" brass plate stamped "RIPCO 1/4 Cor". Probably set by Loftus in 1959 or 1962. Four recently cut BTs as follows:
 14" White Pine, N28°E, 48.47' 14" Jack Pine, S15°W, 33.83'
 12" White Pine, N64°E, 68.66' 6" White Pine, S55°W, 51.74'

I accept this corner position as the accepted local position for the restored Quarter Corner. We placed a plastic sign post on the power pole, East, 1.5'.

(c) (d) (e) Plan view of corner with ties to at least 4 witness monuments. If in disagreement with previously established corner, show the distances between the two corners and also indicate the ties to the disputed corner.

- 1) 1 1/2" x 18" high iron pipe/3" x 3" brass cap.
- 2) 14" White Pine, N28°E, 48.47'.
- 3) 12" White Pine, N64°E, 68.66'.
- 4) 14" Jack Pine, S15°W, 33.83'.
- 5) 6" White Pine, S55°W, 51.74'.
- 6) Plastic Sign Post on power pole, East, 1.5'.

Distances to nail in side of BT.
 Stump blaze scribed "BT".

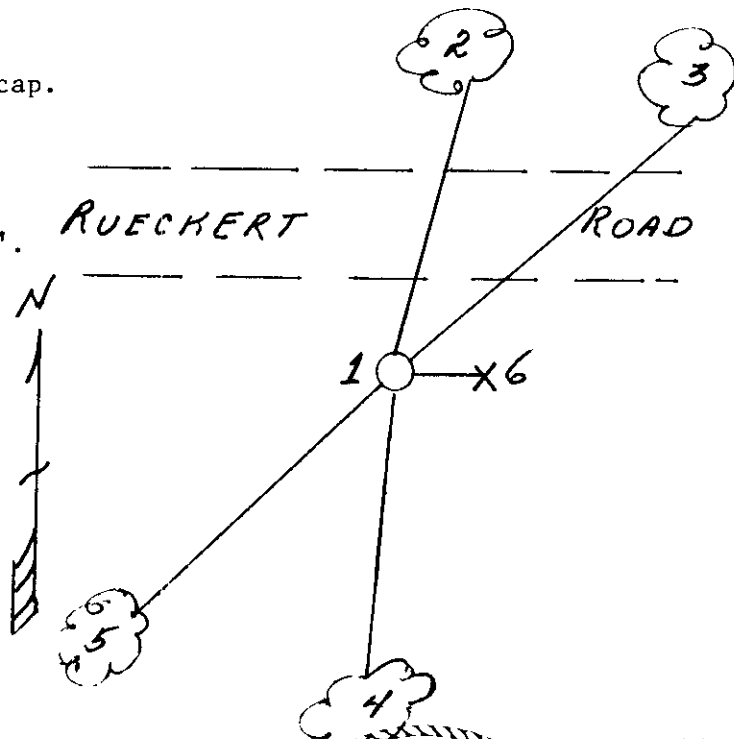

(i) I, Milo E. Stefan
 (type or print name) certify that the corner location on this record was determined by me or under my direction and control and that this U.S. Public Land Survey Monument Record is correct and complete to the best of my knowledge and belief.

Milo E. Stefan 3/3/92
 Signature Date



Index No. T-21

360926 2000

Stamp