
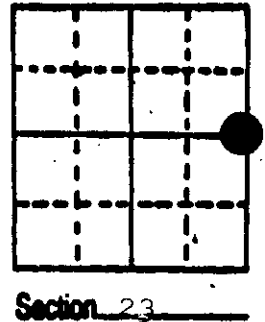


# U.S. PUBLIC LAND SURVEY MONUMENT RECORD

**Note:** This form is intended and designed to fulfill all requirements of Wisconsin Administrative Code, Chapter A-E 5.02, U.S. Public Land Survey Monument Record (3) (a) (b) (c) (d) (e) (f) (g) (h) (i). An additional sheet may be added if necessary to conform with said requirements.


(a) Corner location: Township 37 North  
 Range 6 East/West  
 Town/City/Village Cassian  
 County Oneida

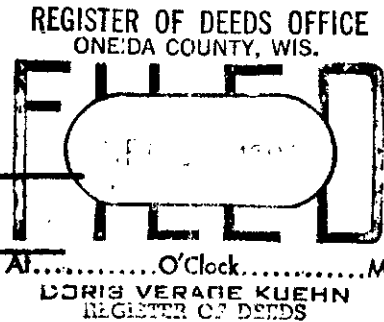

(b) (f) (g) (h) Description of monument found at this corner and if it was accepted, state all evidence (material, testimonial, occupational, plats, records, other monuments) used as a basis for accepting. If not accepted or if nothing was found, state evidence used as basis for establishing location. If reestablished through lost corner proportionate methods, indicate all monuments, distances and directions used to establish.

- 1863 Jenkins established original corner at 40.00 ch. B.T.s aspen 12 S 85 W 13; Aspen 10 S 28 W 14.
- 1936 V. Maine state he went to  $\frac{1}{4}$  corner between 23 and 24 said to be center of Town Road E-W (80.96 East from  $\frac{1}{4}$  stk. between 22 and 23.) An old fence runs North 2702' to corner 23-24-13,14.
- 1954 J. Abernathy indicates corner in road B.T. J. Pine S 20 E 96.0.
- 1963 Ripco indicates corner in Road.
- 1959 Owens Illinois indicates corner in Road by others, dist. to  $C\frac{1}{4}$  2662.44' and dist. to  $\frac{1}{16}$  North = 1284.69.
- 1987 I could not find a monument at the corner so I reestablished the corner from Owens Illinois dist. from the  $C\frac{1}{4}$  and Abernathy's B.T. The corner fell near the center line of the road, I set an Oneida Capped Monument and witnessed it as shown. This position checks closely with Maines Distance to the NE corner and  $W\frac{1}{2}$  of Section 23.


(c) (d) (e) Plan view of corner with ties to at least 4 witness monuments. If in disagreement with previously established corner, show the distances between the two corners and also indicate the ties to the disputed corner.

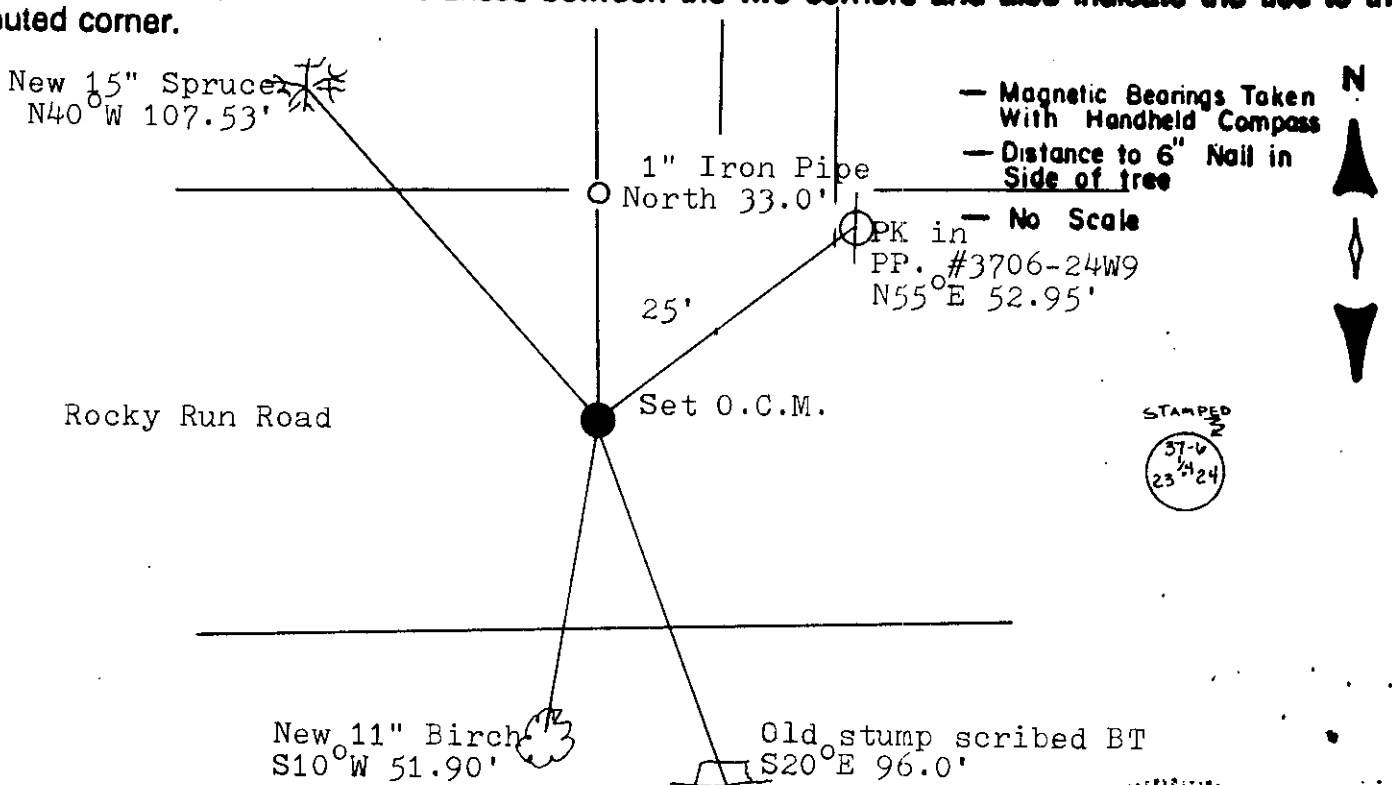

(i) I, Michael J. Romportl  
 (type or print name) certify that the corner location on this record was determined by me or under my direction and control and that this U.S. Public Land Survey Monument Record is correct and complete to the best of my knowledge and belief.

Michael J. Romportl 3/23/87  
 Signature Date

GENISOT & ASSOCIATES INC.  
 1512 EAGLE ST., RHINELANDER, WIS.

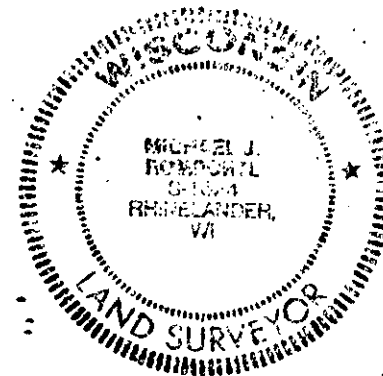

Folder No. P-21


3706232000

# US PUBLIC LAND SURVEY MONUMENT RECORD

Per Wis. Admin. Code § A-E 7.08, a U.S. public land survey monument record shall be prepared and filed with the county survey records as part of any land survey within 60 days of setting or accepting the corner, which includes or requires the perpetuation, restoration, or use of a U.S. public land survey corner and when any of the situations in Wis. Admin. Code § A-E 7.08(1)(a), 7.08(1)(b) or 7.08(1)(c) arise.

3(a) Corner location: WISCRS: Oneida County  
 Found PK Nail N: 180530.80 (measured) 180,531.004 (record)  
 East 1/4 Corner E: 191,908.66 (measured) 191,908.491 (record)  
 Section 23 Datum: NAD 83 (2011)  
 Township 37 North GNSS Control: WISCORS VRS Network  
 Range 06 East GNSS Method: RTK - Direct  
 4th Principal Meridian Verification Method: 1, 2  
 Town of Cassian  
 Oneida Co., WI

The coordinate value, if shown, has been verified by at least one of the following methods: 1) comparison to a previously GNSS determined published value; 2) The value is the average of two or more GNSS observations at markedly different times; 3) one or more distances were measured to the corner from temporary GNSS observed offset locations.

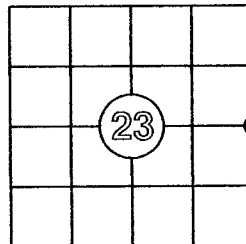

**CORNER ID:**  
3706232000


(b) History of Original Corner  
 Corner Set: Wood Post Original Bearing Trees:  
 Original Surveyor: J.H. Jenkins 12" Aspen- S 85° W, 13 links  
 Date of Survey: 1863 10" Aspen - S 28° W, 14 links

(b)(f)(g)(h) Description of monument found at this corner and, if it was accepted, state all evidence (material, testimonial, occupational, plats, record, other monuments) used as a basis for establishing location. If re-establishing through lost corner proportionate methods, indicate all monuments, distances and directions used to establish this location. Indicate type of monument and sign post found or set.

This is a perpetuation of a previous USPLSS Monument Record by Surveyor Michael J. Romportl, S-1624, dated March 23rd, 1987. See previous record for additional history on this corner.

- 1987 - Michael Romportl re-established location with a set Oneida County capped monument at the intersection of Rocky Run and a road north (Buck Lane).
- 2005 - Dennis Roberts find Oneida County Monument (O.C. Map No. L2133)
- 2009 - Gene Uttech finds PK Nail at this location (O.C. Map No. L2640).
- 6/8/2020 - I found a PK Nail at the intersection of Rocky Run Road and Buck Lane. Measurements to the NE section corner, the CE 1/16 corner and the C 1/4 corner match measured dimensions by other surveyors, so I accept this as the correct location. The NE power pole, by Romportl, has been replaced and that dimension is no longer valid. I could not find the old stump (SE) or the birch (SW). The spruce (NW) is still in place but is now a 24" spruce. The 1" iron pipe (N) is still in place. I set 2 new reference monuments and accepted an additional existing pipe, as shown below.


(c)(d)(e) Plan view of corner with ties to at least 4 witness monuments. If in disagreement with previously established corner, show the distances between the two corners and also indicate the ties to the disputed.

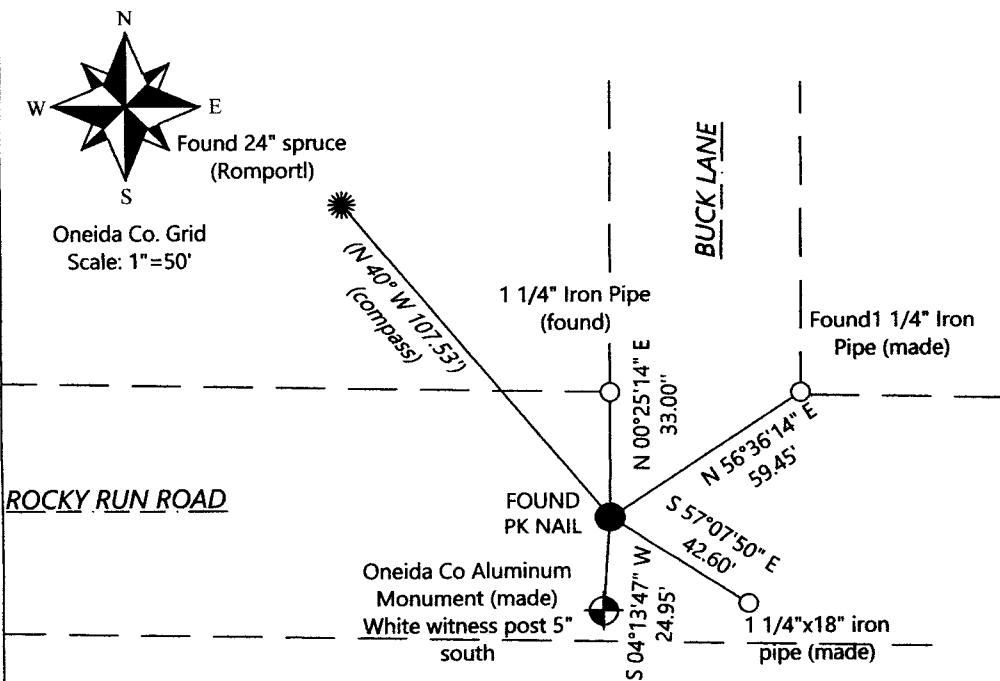

REGISTER OF DEEDS OFFICE  
ONEIDA COUNTY  
FILED

SEP 04 2020

KYLE J. FRANSON  
REGISTER OF DEEDS

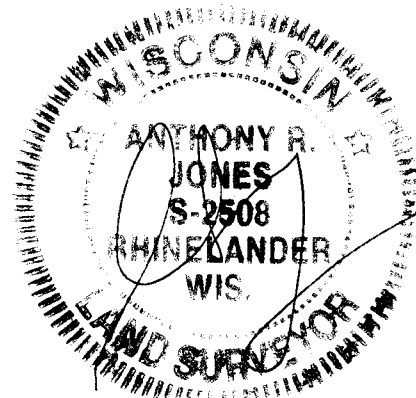

(i) I, Anthony R. Jones, Wisconsin Professional Land Surveyor No S-2508, hereby certify that the corner location shown on this record was determined by me, or under my direction or control, and that this U.S. Public Land Survey Monument Record is correct and complete to the best of my knowledge and belief.

*[Signature]*  
 Anthony R. Jones, PLS No. S-2508  
 Date 9/21/2020

Index No. P-21