


# U.S. PUBLIC LAND SURVEY MONUMENT RECORD

Note: This form is intended and designed to fulfill all requirements of Wisconsin Administrative Code, Chapter A-E 5.02, U.S. Public Land Survey Monument Record (3) (a) (b) (c) (d) (e) (f) (g) (h) (i). An additional sheet may be added if necessary to conform with said requirements.

(a) Corner location: Township 37 North  
 Range 8 East/West  
 Town/City/Village Newbold  
 County Oneida

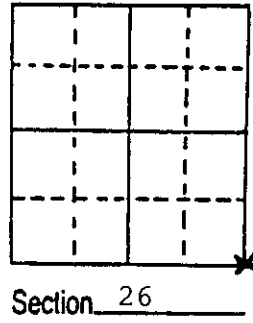


(b) (f) (g) (h) Description of monument found at this corner and if it was accepted, state all evidence (material, testimonial, occupational, plats, records, other monuments) used as a basis for accepting. If not accepted or if nothing was found, state evidence used as basis for establishing location. If reestablished through lost corner proportionate methods, indicate all monuments, distances and directions used to establish.

July 1863; Wm. E. Daugherty set wood post for section corner.  
 Original BTs: 10" White Pine, N5°E, 12 links (7.92').  
 24" Red Pine, S50°W, 39 links (25.74').  
 November 18, 1987, Milo E. Stefan found:  
 1. 2" x 18" aluminum pipe slipped over a 1" x 60" iron pipe.  
 2. 8" White Pine, scribed "BT" with large nail on side, S24°E, 39.02'.  
 3. Large nail on side of power pole #3708-35E20, S65°W, 37.21'.  
 4. Area has been cut for abandoned old highway #47.  
 I accept these pipes as the best remaining evidence of this corner.

(c) (d) (e) Plan view of corner with ties to at least 4 witness monuments. If in disagreement with previously established corner, show the distances between the two corners and also indicate the ties to the disputed corner.

1. 2" x 3" Oneida County aluminum monument, 24" in ground.
  2. 12" Red Pine, N70°E, 29.38'.
  3. 8" White Pine, S24°E, 39.02'.
  4. Power pole #3708-35E20, S65°W, 37.21'.
  5. Power pole #3708-26R21, N2°W, 182.30'.
  6. White plastic sign post, East 1.0'.
- Pipes driven to ground line alongside new monument.  
 Measurements to nails in side of BT's and references.

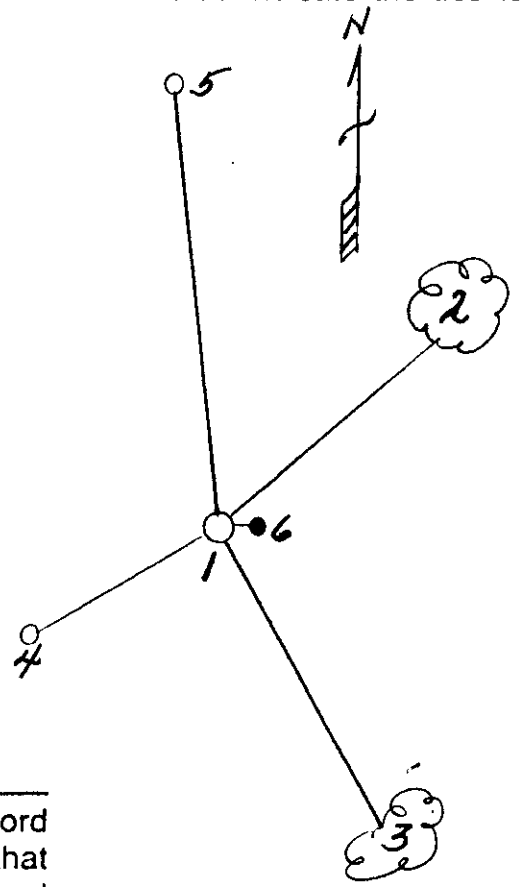

(i) I, Milo E. Stefan  
 (type or print name) certify that the corner location on this record was determined by me or under my direction and control and that this U.S. Public Land Survey Monument Record is correct and complete to the best of my knowledge and belief.

Milo E. Stefan 11/19/87  
 Signature Date

Index No. V-21

3708260000