


MAP # **A0913**
 DATE FILED **OCT 08 1999**
 BY **SK**
 DESCRIPTION FILED
 ONEIDA CO. SURVEYOR'S OFFICE

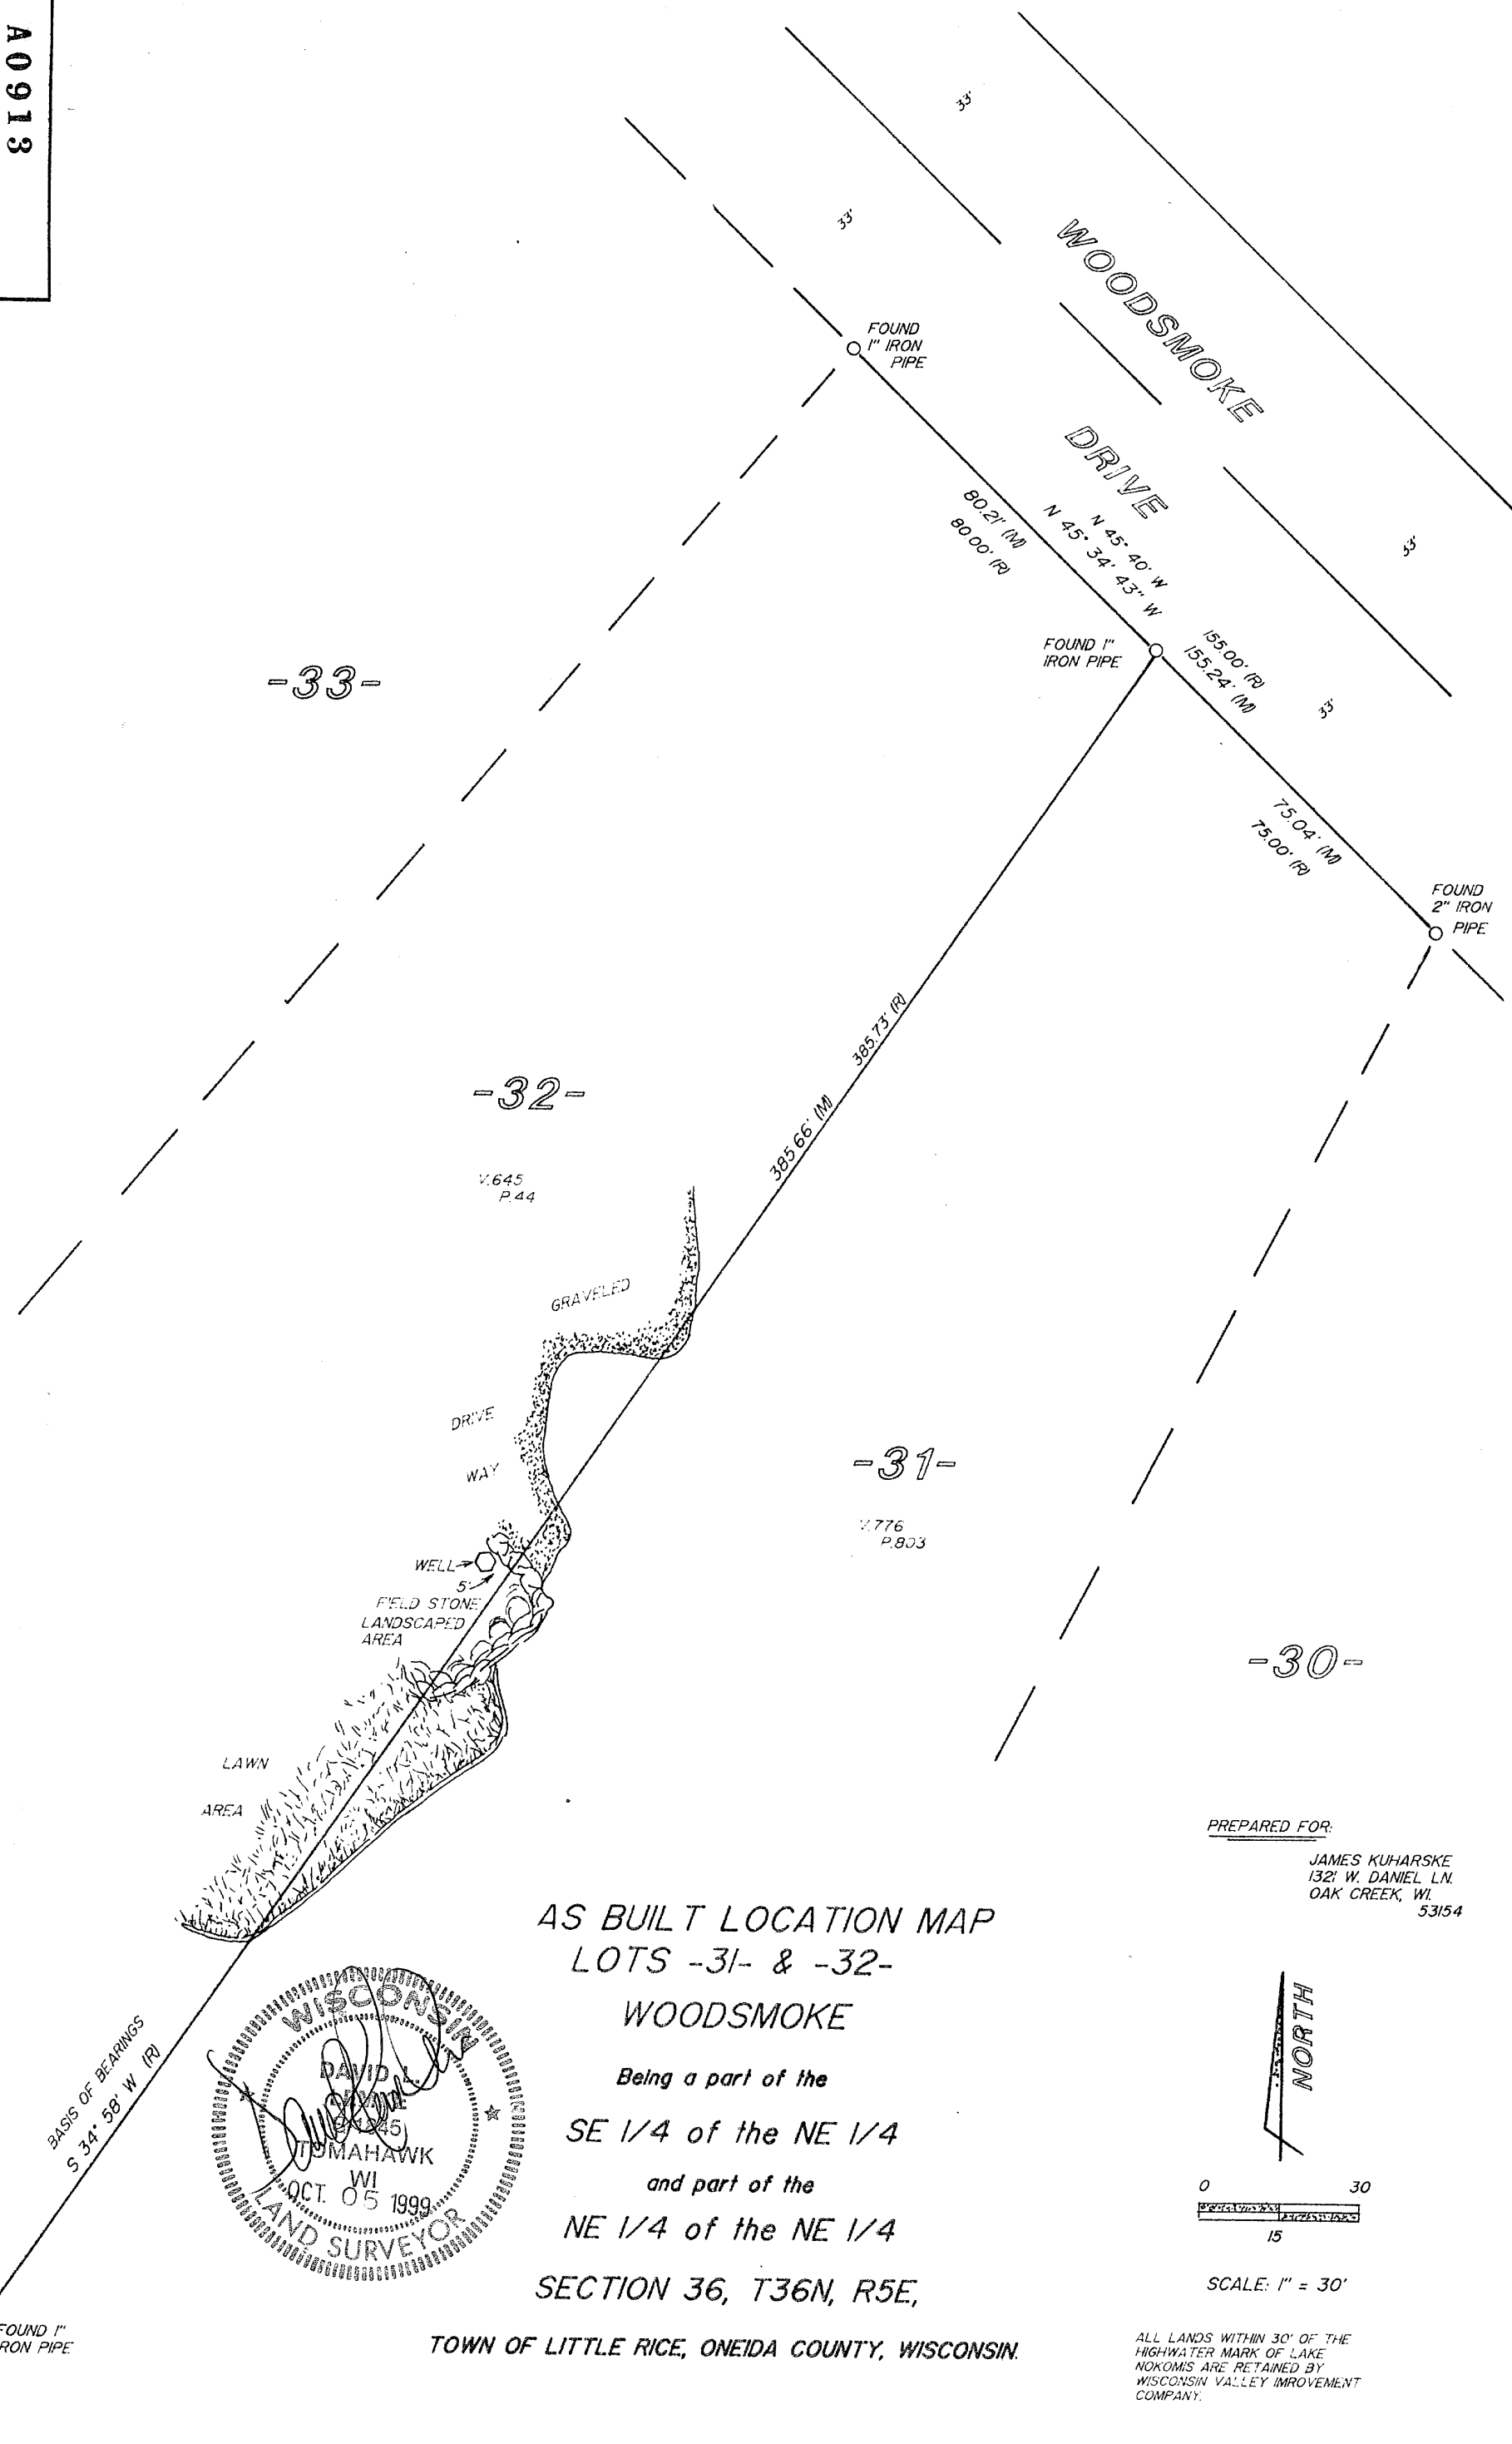

-33-

-32-

-31-


-30-

V.645
P.44

V.776
P.803

PREPARED FOR:
 JAMES KUHARSKE
 132' W. DANIEL LN.
 OAK CREEK, WI.
 53154

AS BUILT LOCATION MAP
 LOTS -31- & -32-
 WOODSMOKE
 Being a part of the
 SE 1/4 of the NE 1/4
 and part of the
 NE 1/4 of the NE 1/4
 SECTION 36, T36N, R5E,
 TOWN OF LITTLE RICE, ONEIDA COUNTY, WISCONSIN.

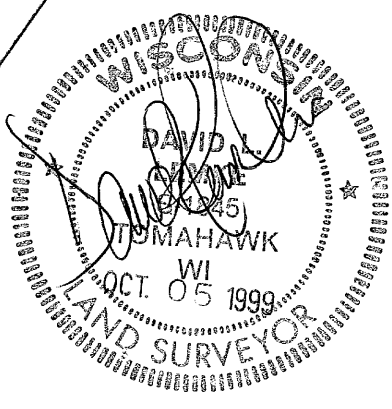

HIGHWATER
 MARK LAKE
 NOKOMIS

BASIS OF BEARINGS
 S 34° 58' W 17' (R)

FOUND 1" IRON PIPE

ALL LANDS WITHIN 30' OF THE
 HIGHWATER MARK OF LAKE
 NOKOMIS ARE RETAINED BY
 WISCONSIN VALLEY IMPROVEMENT
 COMPANY.