

MAP # B3973
 DATE FILED AUG 03 1998
 BY JB
 DESCRIPTION FILED
 ONEIDA CO. SURVEYOR'S OFFICE

AS BUILT ROAD LOCATION MAP

Located in

GOV'T LOT 1

SECTION 9, T36N, R6E,

TOWN OF NOKOMIS, ONEIDA COUNTY, WISCONSIN

LANDS OWNED BY V.640 4 STATES TIMBER P.210
 APPROXIMATE NORTH LINE GOV'T LOT 1
 NE CORNER GOV'T LOT 1 BY OTHERS
 FOUND 2" IRON PIPE

V.282
 P.75

LANDS OWNED BY RAYMOND CATTELL
 SECTION 10, T36N, R6E
 GOV'T LOT 5

LANDS OWNED BY ALLAN CRAMER
 UNDER LAND CONTRACT TO ROBERT HARSLA

V.817
 P.276

EXISTING SLAB
 EXISTING SLAB

TRAVELED PORTION OBLITERATED

GOV'T LOT 1
 APPROXIMATE EAST LINE

V.640
 P.210

LANDS OWNED BY 4 STATES
 TIMBER

APPROXIMATE WEST LINE
 GOV'T LOT 1

APPROXIMATE NORTH LINE V.767 P.66

LANDS OWNED BY ALLAN CRAMER
 UNDER LAND CONTRACT TO ROBERT FELLNER & TIMOTHY SWIM

V.767
 P.66

ROAD RELOCATED FROM EXISTING TRAVELED
 EXISTING SLAB
 EXISTING CABIN
 TRAVELED PORTION OBLITERATED

TOMAHAWK RIVER

SCALE 1" = 100'
 0 50 100
 1/2" = 100'


NORTH

PREPARED FOR RAYMOND CATTELL
 5509 MIDMOOR RD
 MONONA, WISCONSIN 53716

TRAVELED PORTION OF ROAD 10' WIDE
 RIVER LOCATION APPROXIMATE

FOUND 1 1/2" IRON PIPE
 SW CORNER GOV'T LOT 1
 SET BY OWENS - ILLINOIS
 FOREST PRODUCTS DIVISION
 1963

APPROXIMATE SOUTH LINE GOV'T LOT 1

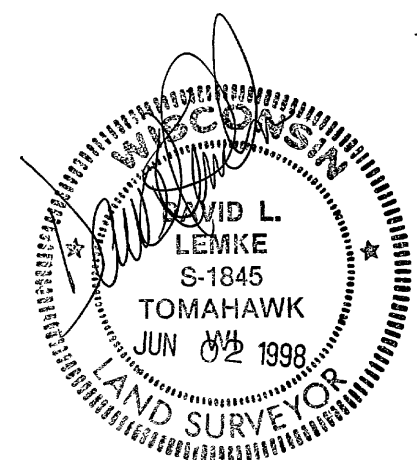

6-2-98

BOUNDARY HUNTER
 DAVID L. LEMKE RLS
 P.O. BOX 442
 TOMAHAWK, WI 54487
 715-453-7035