

CHECKED:	SCOTT GROHOLSKI
DRAWN:	CYNTHIA MILLER
DATE:	3-23-07
PROJECT NO.	07-515


TOPOGRAPHIC MAP

POINT ROAD WEST DRAINAGE
TOWN OF NAKOMIS
ONEIDA COUNTY, WISCONSIN

LAND SURVEYING
LANDSCAPE ARCHITECTURE
ENGINEERING
5709 WINDY DRIVE, SUITE D
STEVENS POINT, WI, 54481
(715) 344-9999

POINT
ENGINEERING INC

TOPO

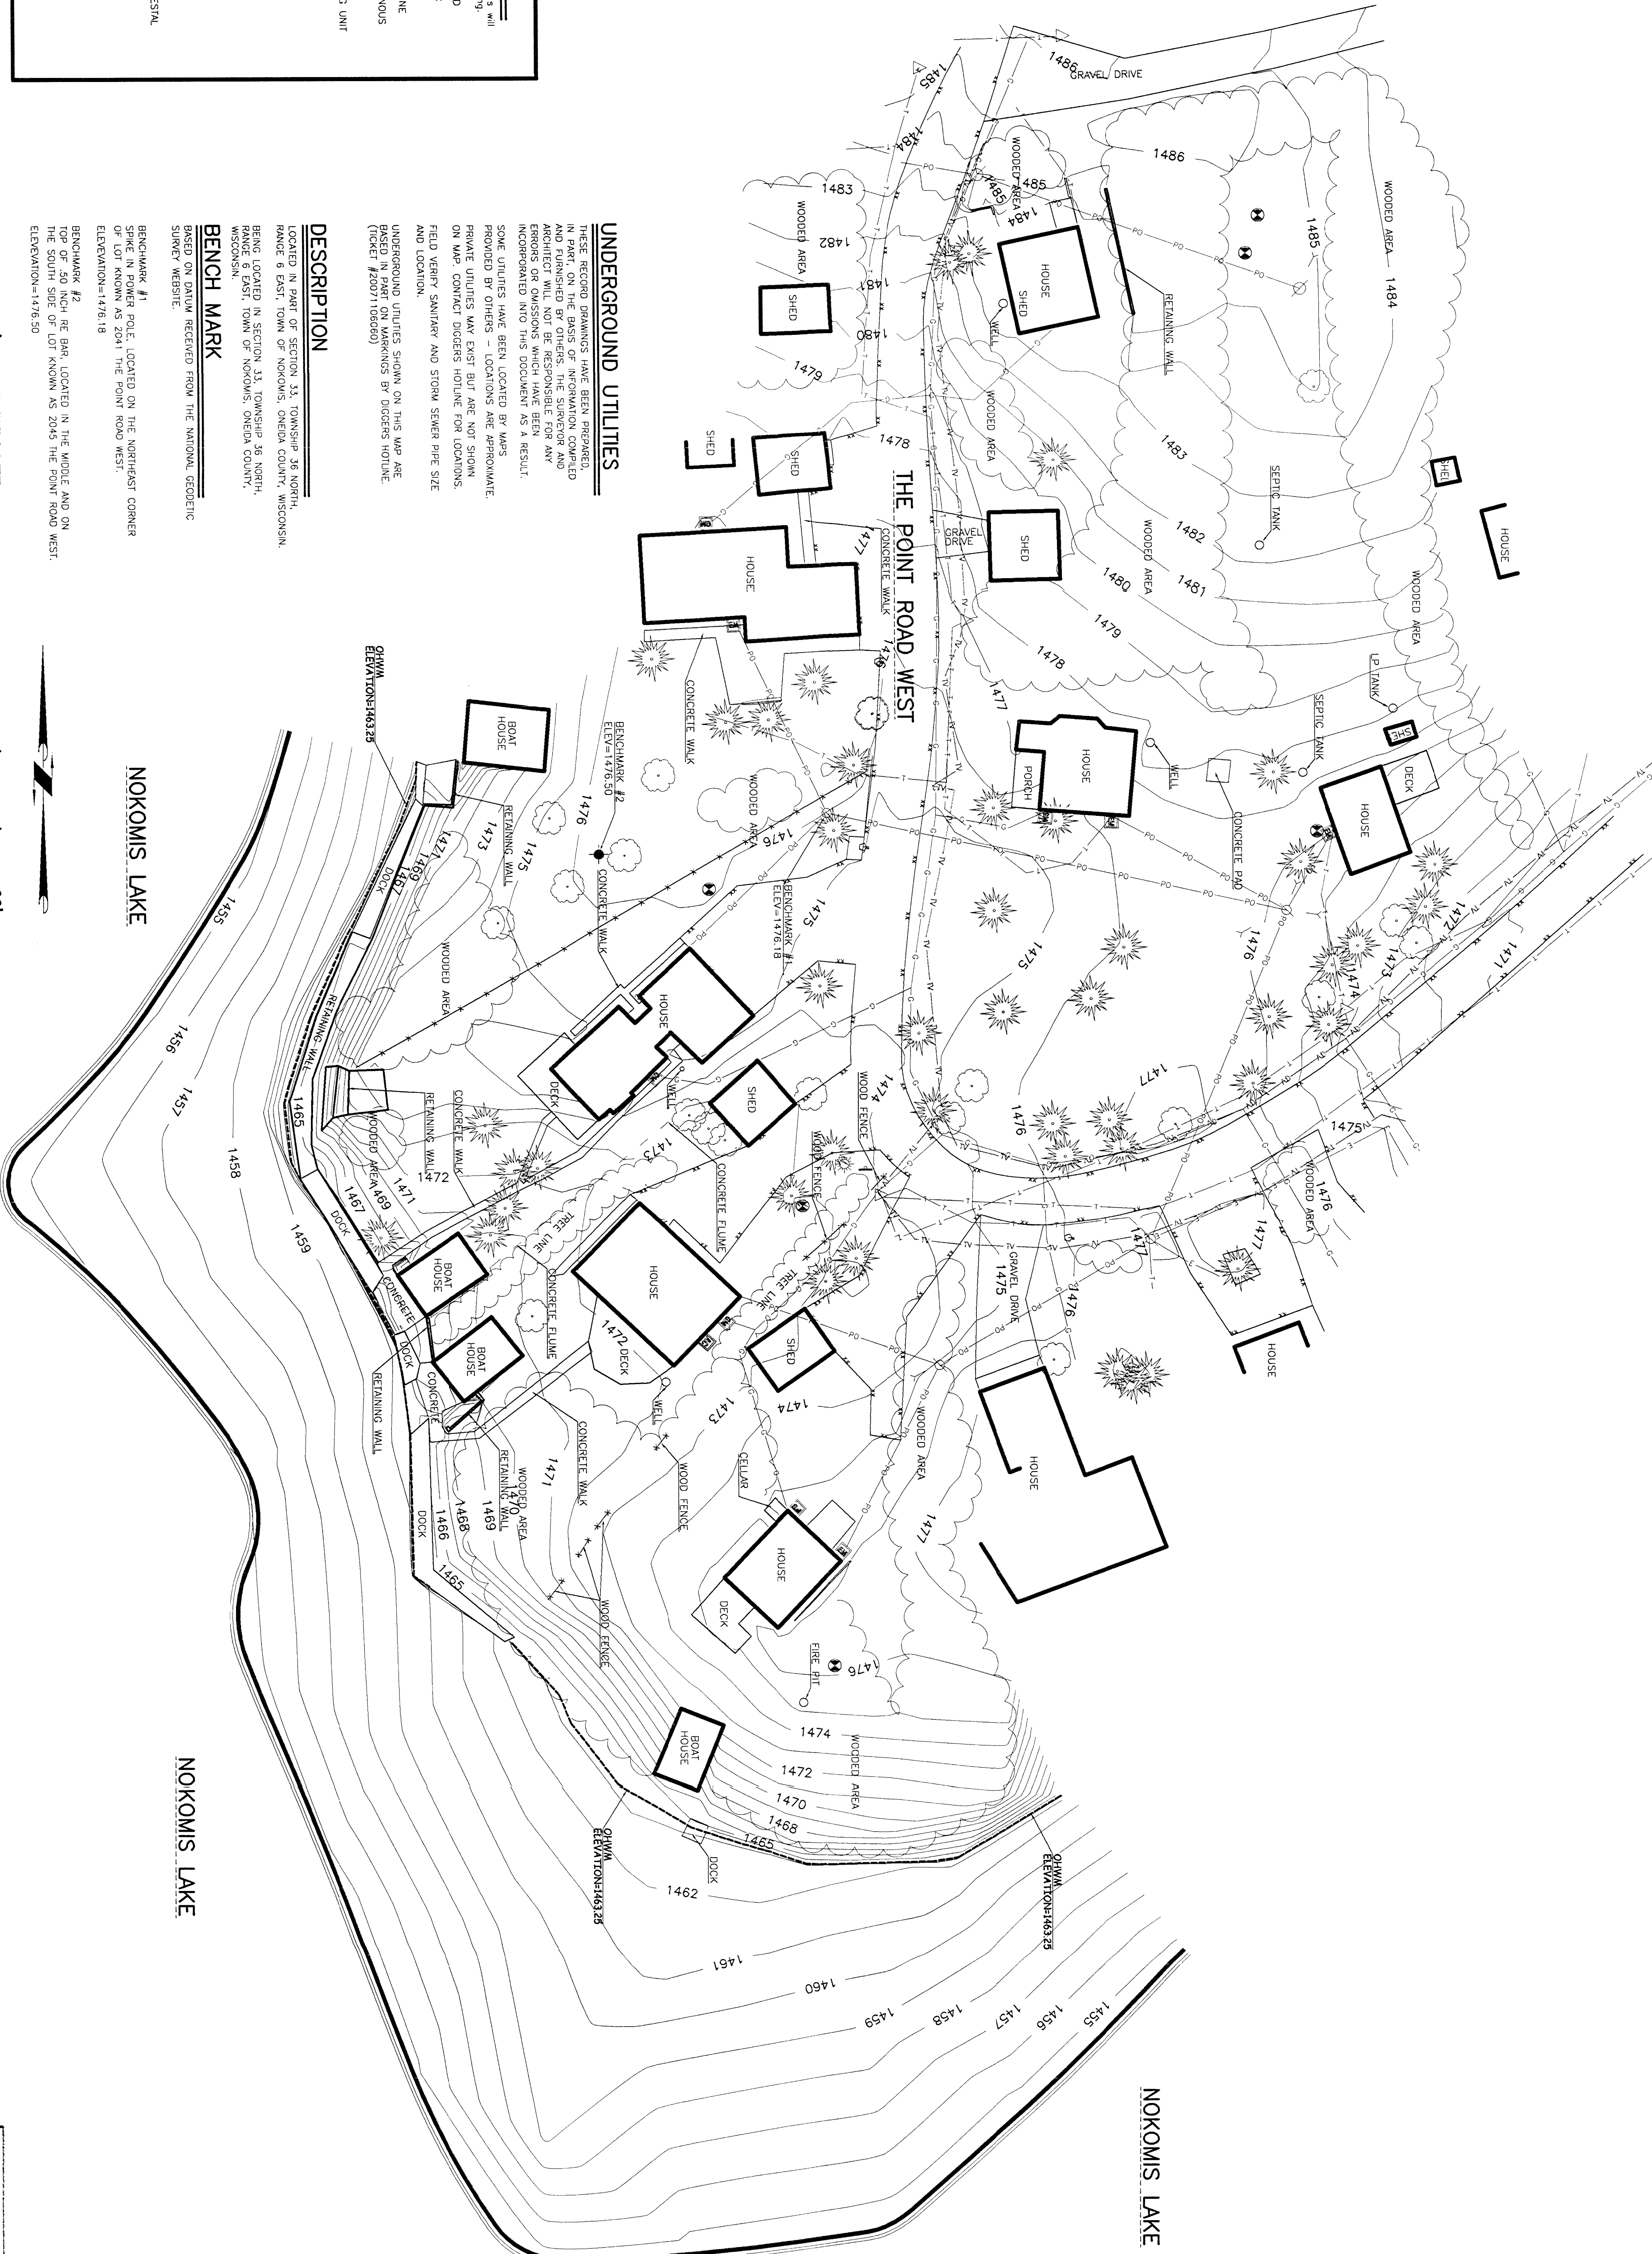

LEGEND

- These standard symbols will be found in the drawing
- POWER OVERHEAD
 - BURIED ELECTRIC
 - BURIED GAS
 - BURIED TELEPHONE
 - EDGE OF BRIMINIOUS
 - CONTOUR LINE
 - AIR CONDITIONING UNIT
 - ELECTRIC METER
 - GAS METER
 - GUY WIRE
 - LIGHTPOLE
 - MAILBOX
 - POWERPOLE
 - SIGN
 - TELEPHONE PEDSTAL
 - VENT PIPE
 - TREE
 - PINE TREE

UNDERGROUND UTILITIES

THESE RECORD DRAWINGS HAVE BEEN PREPARED BY THE SURVEYOR AND ARE NOT TO BE USED FOR ANY OTHER PURPOSE. THE SURVEYOR AND ARCHITECT WILL NOT BE RESPONSIBLE FOR ANY ERRORS OR OMISSIONS WHICH HAVE BEEN INCORPORATED INTO THIS DOCUMENT AS A RESULT. SOME UTILITIES HAVE BEEN LOCATED BY WMS PROVIDED BY OTHERS - LOCATIONS ARE APPROXIMATE. PRIVATE UTILITIES MAY EXIST BUT ARE NOT SHOWN ON MAP. CONTACT DODGERS HOLDING FOR LOCATIONS, FIELD VERIFY SANITARY AND STORM SEWER PIPE SIZE AND LOCATION.

UNDERGROUND UTILITIES SHOWN ON THIS MAP ARE BASED ON PART ON MARKINGS BY DODGERS HOLDING (TICKET #2007106666)

DESCRIPTION

LOCATED IN PART OF SECTION 32, TOWNSHIP 37 NORTH, RANGE 9 WEST, TOWN OF NAKOMIS, ONEIDA COUNTY, WISCONSIN. BEING LOCATED IN SECTION 33, TOWNSHIP 36 NORTH, WISCONSIN. TOWN OF NAKOMIS, ONEIDA COUNTY, WISCONSIN.

BENCHMARK

BASED ON DATUM RECEIVED FROM THE NATIONAL GEODESIC SURVEY WEBSITE.

BENCHMARK #1
SPINE IN POWER POLE, LOCATED ON THE NORTHEAST CORNER OF LOT 1476. ELEVATION=1476.18

BENCHMARK #2
TOP OF 50 INCH RE BAR, LOCATED IN THE MIDDLE AND ON THE SOUTH SIDE OF LOT KNOWN AS 5045 THE POINT ROAD WEST. ELEVATION=1476.50

SURVEYOR'S CERTIFICATE

I, SCOTT GROHOLSKI, REGISTERED LAND SURVEYOR IN THE STATE OF WISCONSIN, DO HEREBY CERTIFY THAT THIS IS A TRUE AND CORRECT COPY OF A TOPOGRAPHICAL SURVEY AS MADE BY ME ON MARCH 21-22, 2007.

DATED THIS _____ DAY OF _____, 2007.
SCOTT GROHOLSKI, (# 2281)
REGISTERED LAND SURVEYOR



MAP #	03041
DATE FILED	3-23-15
BY	JB
DESCRIPTION FILED	
ONEIDA CO. SURVEYOR'S OFFICE	