

September 9, 1992


L1199

Oneida County Planning & Zoning Committee has no objection to this

certified Survey. Date: March 8th, 1976

John W. Denny
Administrator

Recovered, verified and marked iron pipes on the southwest line of Lots 1, 2, 3 and 4 as shown in red, and marked line between corners as highlighted in pink with fluorescent flagging ribbon, by order of James McBride, who has executed a written waiver for all other requirements of Wis. Adm. Code Chap. A-E 7.

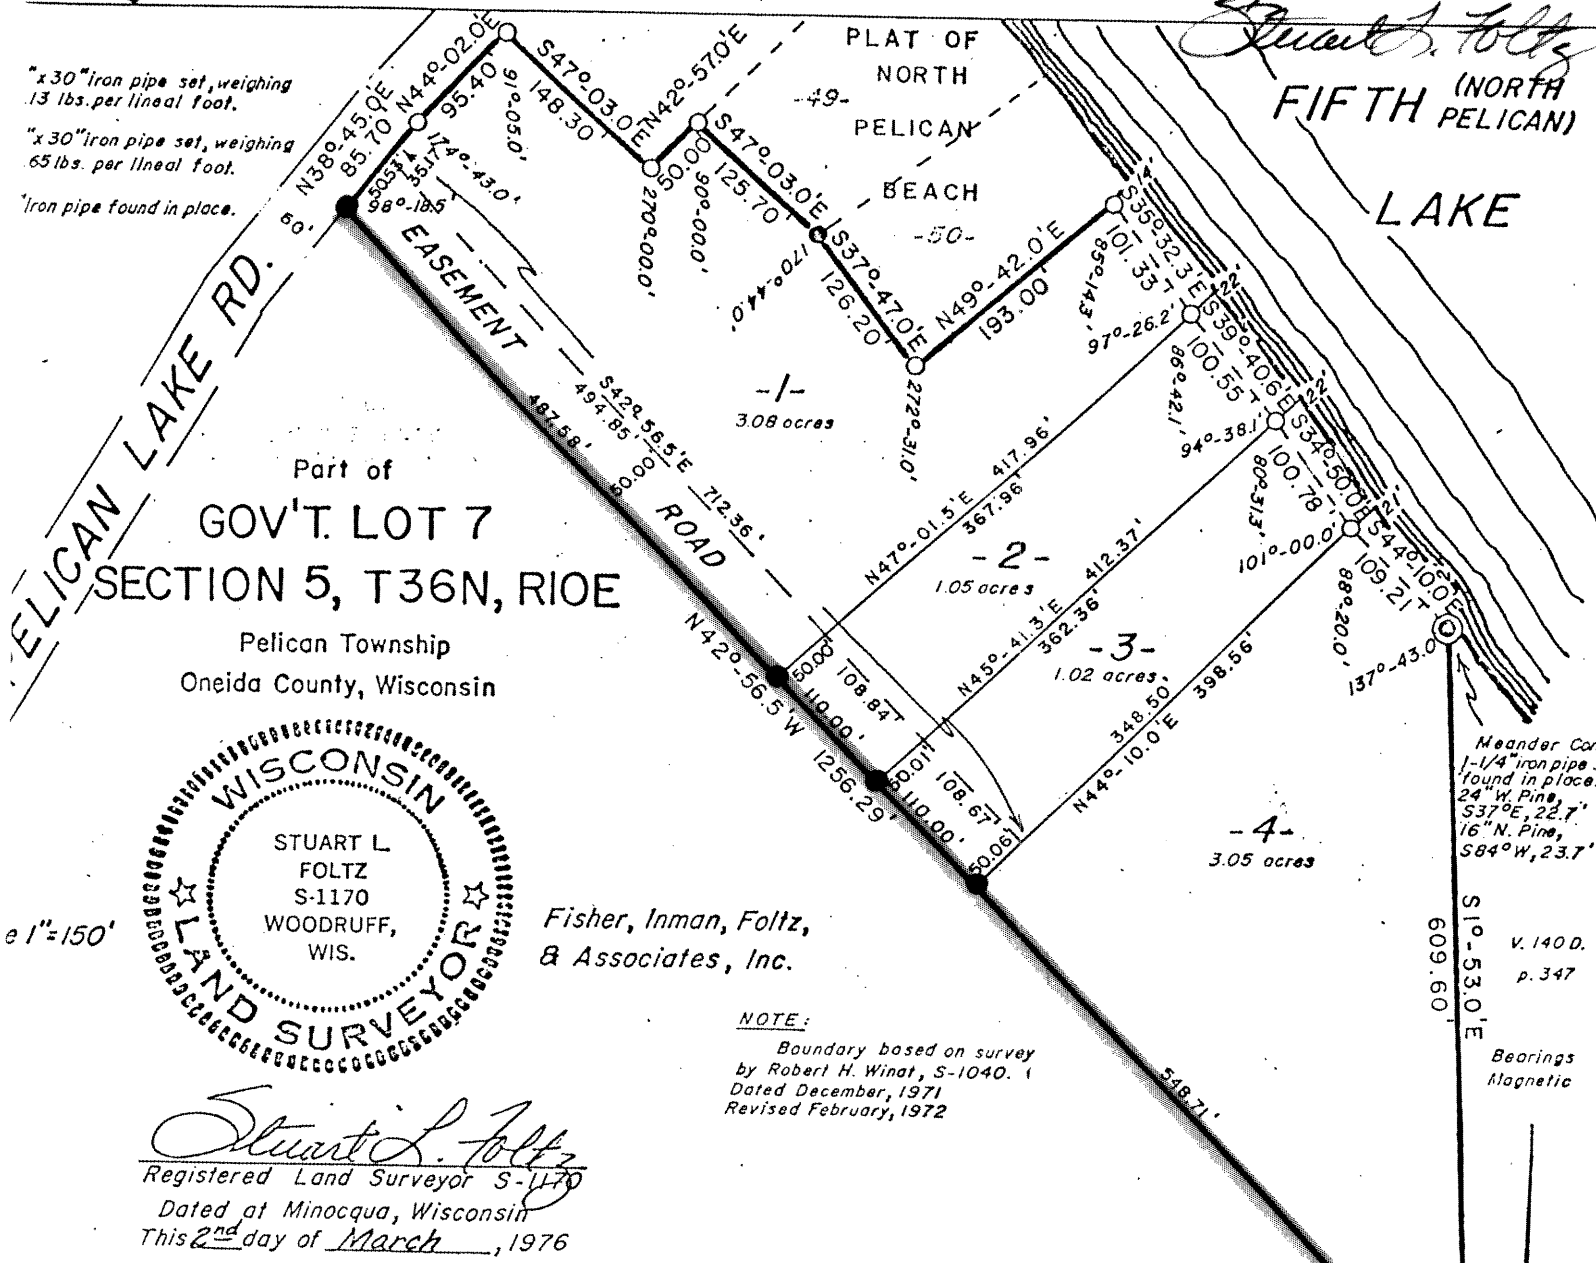

1"=150'

Meander Corn.
1-1/4" iron pipe
found in place.
24" W. Pine,
S37°E, 22.7'
16" N. Pine,
S84°W, 23.7'
S1°-53.0'E
609.60'
V. 140 D.
p. 347
Bearings
Magnetic

NOTE:
Boundary based on survey
by Robert H. Winat, S-1040. 1
Dated December, 1971
Revised February, 1972

Stuart L. Foltz
Registered Land Surveyor S-1170
Dated at Minocqua, Wisconsin
This 2nd day of March, 1976

PARCELS 1, 2, 3 and 4, being part of Gov't Lot 7, Section 5, T36N, R10E, Pelican Township, Oneida County, Wisconsin, more particularly described as follows:

Beginning at the westerlymost corner of Lot 50, Plat of North Pelican Beach, marked by a 1" iron pipe; thence S37°-47.0'E, 126.20 feet along the southwesterly line of said Lot 50 to a 2" iron pipe; thence N49°-42.0'E, 193.00 feet along the southeasterly line of said Lot 50 to a 2" iron pipe near the southerly shore of Fifth Lake; thence along the lake S35°-32.3'E, 101.33 feet to a 2" iron pipe; S39°-40.6'E, 100.55 feet to a 2" iron pipe; S34°-50.0'E, 100.78 feet to a 2" iron pipe and S44°-10.0'E, 109.21 feet to a meander corner on the line between Gov't Lots 7 and 8, marked by a 1-1/4" iron pipe, witnessed by a 24" White Pine bearing S37°E, 22.7 feet and a 16" Norway Pine bearing S84°W, 23.7 feet; thence S1°-53.0'E, 609.60 feet to a 1" iron pipe; thence N42°-56.5'W, 1256.29 feet to a 2" iron pipe on the southeasterly right-of-way line of North Pelican Lake Road; thence along said right-of-way line N38°-45.0'E, 85.70 feet to a 2" iron pipe and N44°-02.0'E, 95.40 feet to a 2" iron pipe; thence S47°-03.0'E, 148.30 feet to a 2" iron pipe; thence N42°-57.0'E, 50.00 feet to a 2" iron pipe at the westerlymost corner of Lot 49, Plat of North Pelican Beach; thence S47°-03.0'E, 125.70 feet along the southwesterly line of said Lot 49 to the place of beginning.

Including also all lands lying between the meander lines and the southerly shore of Fifth Lake.

SURVEYOR'S CERTIFICATE

I, Stuart L. Foltz, Registered Land Surveyor No. S-1170 hereby certify that we have surveyed the above described property; that this plat is an accurate survey and a true representation thereof and correctly shows the exterior boundary lines and the correct measurements thereof; that we have made such survey by order of DOUGLAS DEVOS, and that we have complied with Chapter 236.34 of the Wisconsin Statutes.

RECEIVED & FILED
Oneida County Surveyor's Office
Date: SEP 21 1992
By: [Signature]
OCS AFB

L1199

L1199