

CERTIFIED LAND CORNER RESTORATION

State of Wisconsin }
County of ONEIDA } ss.

I William Immich do hereby certify that on the 5th day of November, 1981, I found evidence of the Southwest corner of Section 18 Township 35 North, Range 9 East, Fourth Principal Meridian, as described hereon; and that from this evidence I established a new monument and accessories as described hereon to perpetuate the original location of this corner:


Description of original monument and accessories and subsequent restorations:

H. Fellows 1859 Government Surveyor 80.00 Set corner to 13, 18, 19 & 24
Birch 14 S 24 E 25 / Birch 10 N 33 W 13 / Birch 12 N 35 E 22 / Lind. 10 S 53 E 15 / Sugar 12 S 33 E 16 1/2

V.M. Daine 1935 Identified by E.N. Moran as location of Original Corner found old stake, pile of rocks, found stump holes Original bearing trees, found D.R. Vaughn bearing tree Sugar 26 S 33 E 16 1/2, Set capped iron pipe, new bearing tree 112. Oak 7 S 31 E 67 3/4

Description of corner evidence found:

Found V.M. Daine's capped iron pipe Stamped as shown
Pipe in small rock pile, line cut to west.

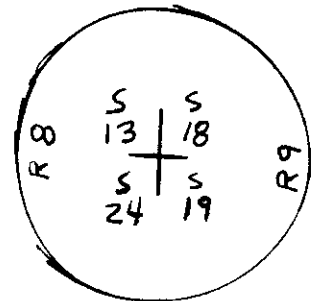


Description of monument and accessories I established to perpetuate the location of this corner:

Monument in good condition made new bts,
Twin oak 18 N 11 W 30.92' / Oak 6 S 64 W 7.35'
Maple 5 N 88 E 15.97'

bearings mag. dist to p.k. in blaze scribed
B.T.



*Compared with record data and found to be correct & accepted.
Robert H. Strick, County Surveyor
2000-0000 (1981)*

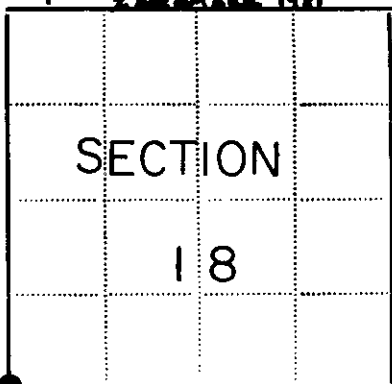

Resident witnesses.....

Dated at Rhineland Wisconsin, this 5th day of Nov. 1981

Signature William Immich Title R.L.S.
(County Surveyor, Registered Land Surveyor, or other duly authorized official)

Surveyors Registration No. 1383

Office of Register of Deeds County of Oneida

I hereby certify that the within instrument was filed in this office for record on the 21st day of December 1981, and was filed in Book No. Page No. of County Records.

Signature Louis George Kuehn Title Register of Deeds

Township 35 N., Range 9 E., Section 18, Index No. N-1, Page No.

