



CERTIFIED LAND CORNER RESTORATION

State of Wisconsin }  
County of ONEIDA } ss.

I, William Immich, do hereby certify that on the 5th day of November, 1981, I found evidence of the West 1/4 corner of Section 18 Township 35 North, Range 9 East, Fourth Principal Meridian, as described hereon; and that from this evidence I established a new monument and accessories as described hereon to perpetuate the original location of this corner:

Description of original monument and accessories and subsequent restorations:


1859 follows 1859 Government Surveyor north between 13 & 18 Var. 8° 30' S 40.00 Set 1/4 Post Birch 8 N26E 5/ Hemlock 7 S30W 15

1899 L.P. Dorr made new bt Sugar 8 S40 1/2 N 17 3/4

1935 V.M. Mains set corner from Dorr's bearing tree found stump set capped iron pipe made new bearing tree Sugar 14 S14 1/2 S 36 1/4

Description of corner evidence found:

Found V.M. Mains capped iron pipe. Stamped as shown  
Found scribed wood post next to pipe.

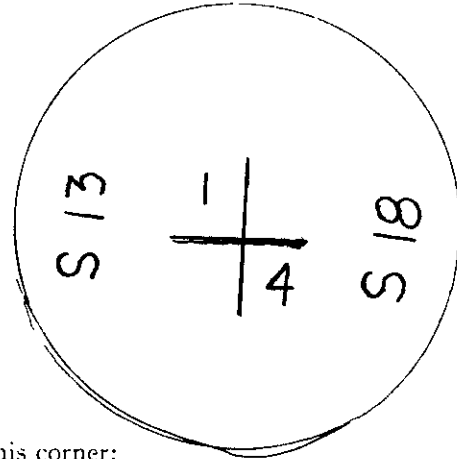


Description of monument and accessories I established to perpetuate the location of this corner:

Iron pipe in good condition made new bts  
Tam. 6 West 10.92' / Maple 6 S1°E 27.75'  
Basswood 5 S88°E 17.00

bearings mag. distances to p.k. in blaze  
scribed 1/4



Compared with record data and found to be correct; accepted.  
Robert H. Hines, Oneida Co. Surveyor  
20 December 1981

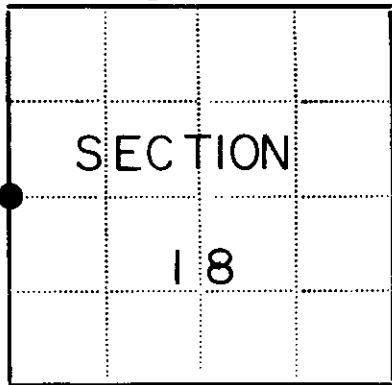

● - Corner monument restored  
□ -

Resident witnesses.....

Dated at Rhineland Wisconsin, this 5th day of Nov. 1981

Signature William Immich Title R.L.S.  
(County Surveyor, Registered Land Surveyor, or other duly authorized official)

Surveyors Registration No. 1383

Office of Register of Deeds County of Oneida

I hereby certify that the within instrument was filed in this office for record on the 21st day of December 1981, and was filed in Book No. .... Page No. .... of County Records.

Signature Loris Verage Kuehn Title Register of Deeds

Township 35 N., Range 9 E., Section 18, Index No. L-1, Page No. ....