U.S. PUBLIC LAND SURVEY MONUMENT RECORD

Note: This form is intended and designed to fulfill all requirements of Wisconsin Administrative Code, Chapter A-E 5.02, U.S. Public Land Survey Monument Record (3) (a) (b) (c) (d) (e) (f) (g) (h) (i). An additional sheet may be added if necessary to conform with said requirements.

(a) Corner location: Township 35 North

Range 9 East/~~West~~

Town/~~City/Village~~ Enterprise

County Oneida

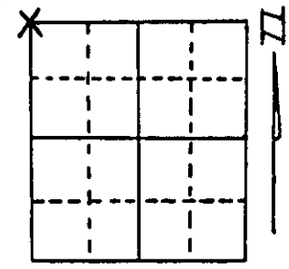

Section 31

(b) (f) (g) (h) Description of monument found at this corner and if it was accepted, state all evidence (material, testimonial, occupational, plats, records, other monuments) used as a basis for accepting. If not accepted or if nothing was found, state evidence used as basis for establishing location. If reestablished through lost corner proportionate methods, indicate all monuments, distances and directions used to establish.

July 4, 1857 Hiram C. Fellows set post for section corner at 80.00 chains:
11" Birch, N15°E, 11 links (7.26')
7" Birch, S65°E, 23 links (15.18')
6" Hemlock, S63°W, 12 links (7.92')
8" Hemlock, N35°W, 20 links (13.20')
March 13, 1935 V. Maine restored corner by lost methods and placed a brass cap on 2" x 60" galv. iron pipe for corner:
9" Cedar, N49°W, 1.37 chains (90.4')
February 12, 1988 Milo E. Stefan found Maine's brass cap atop galv. iron pipe in good condition.

(c) (d) (e) Plan view of corner with ties to at least 4 witness monuments. If in disagreement with previously established corner, show the distances between the two corners and also indicate the ties to the disputed corner.

1. 2" x 60" galv. iron pipe brass cap atop.
2. 5" Hemlock, East, 17.39' ("X BT")
3. 12" Red Maple, S4°E, 25.97' (T35N R9E S31 BT)
4. 4" Sugar Maple, S51°W, 16.56' ("X BT")
5. 5" Sugar Maple, N11°W, 25.16' ("X BT")
6. Plastic sign post NW, 1.6'

Distances to nail in side of BTs.
(Trees scribed as such)

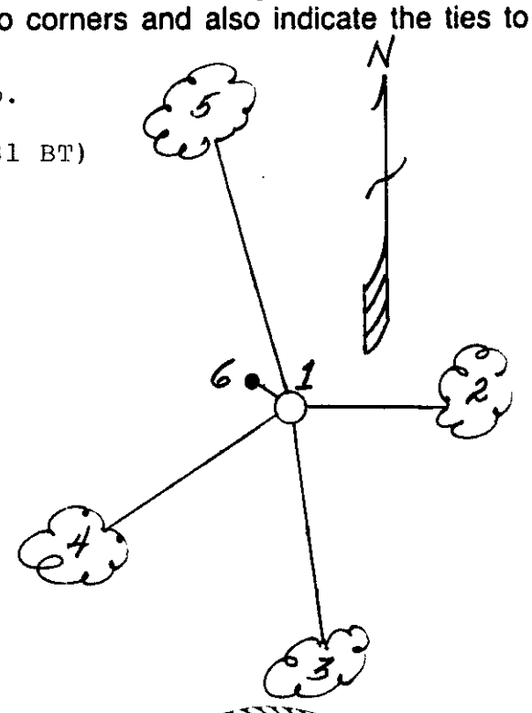

(i) I, Milo E. Stefan (type or print name) certify that the corner location on this record was determined by me or under my direction and control and that this U.S. Public Land Survey Monument Record is correct and complete to the best of my knowledge and belief.

Milo E. Stefan 2/26/88

Signature Date

WISCONSIN MILO E. STEFAN S-1558 RHINELANDER, WIS. LAND SURVEYOR

Index No. V-1

3508250000