


# U.S. PUBLIC LAND SURVEY MONUMENT RECORD

**Note:** This form is intended and designed to fulfill all requirements of Wisconsin Administrative Code, Chapter A-E 7.08 U.S. Public Land Survey Monument Record (3) (a) (b) (c) (d) (e) (f) (g) (h) (i). An additional sheet may be added if necessary to conform with said requirements.

(a) Corner location: Township 35 North  
 Range 9 East/West

Town/City/Village Enterprise

County Oneida

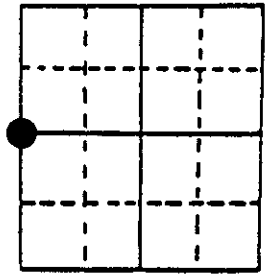

Section 30

(b) (f) (g) (h) Description of monument found at this corner and if it was accepted, state all evidence (material, testimonial, occupational, plats, records, other monuments) used as a basis for accepting. If not accepted or if nothing was found, state evidence used as basis for establishing location. If reestablished through lost corner proportionate methods, indicate all monuments, distances and directions used to establish. Indicate type of monument found or set and sign post.

1859 - Hiram Fellows established this corner and set a wood post with two BTs:  
 16" Birch, S32°E, 16 Links      12" Lynn, N35°W, 15 Links


3/17/1936 - Maine found original Birch BT, dead, and restored corner by placement of a  
 2 1/4" x 60" iron pipe/brass cap and two new BTs:  
 8" Sugar, S48 1/2°W, 34 Links      12" Hemlock, S39°E, 81 Links

12/15/1989 - Milo E. Stefan found Maine's monument in good condition, his BTs gone. We  
 made four new BTs and set plastic sign post.

(c) (d) (e) Plan view of corner with ties to at least 4 witness monuments. If in disagreement with previously established corner, show the distances between the two corners and also indicate the ties to the disputed corner.


- 1) 2 1/4" x 60" iron pipe/brass cap
- 2) 6" Sugar Maple, N87°E, 8.31'
- 3) 6" White Ash, S20°E, 25.66'
- 4) 5" Sugar Maple, S49°W, 35.78'
- 5) 4" Black Ash, N20°W, 30.26'
- 6) Plastic sign post, northwest, 1.0'
- 7) Lincoln County Post, southwest, 7.5'

Distances to nail in side of BTs.  
 Stump blazes scribed "BT".

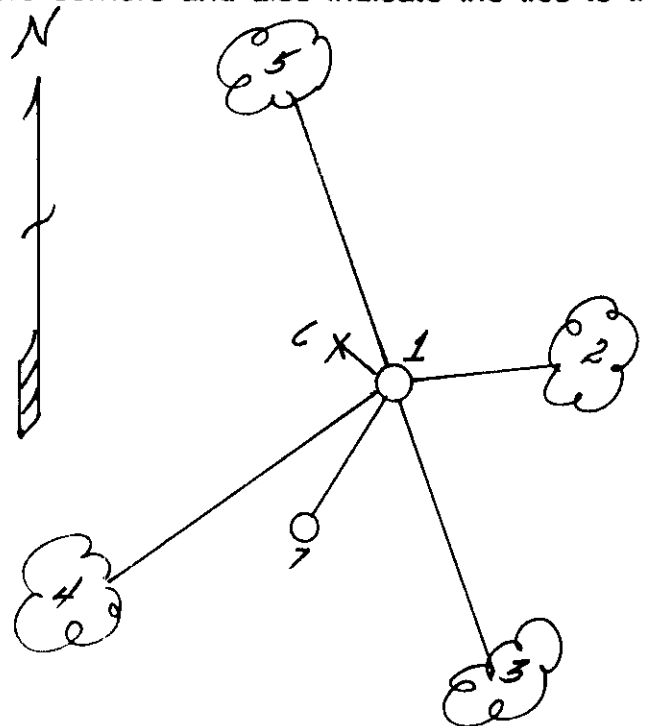

(i) I, Milo E. Stefan  
 (type or print name) certify that the corner location on this record was determined by me or under my direction and control and that this U.S. Public Land Survey Monument Record is correct and complete to the best of my knowledge and belief.

Milo E. Stefan      12/16/89  
 Signature      Date

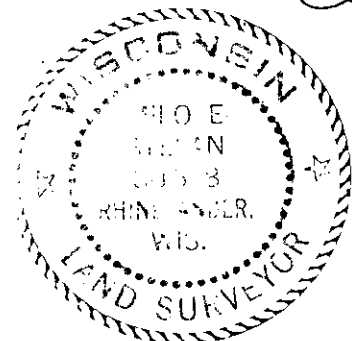

Index No. T-1

350825 2000

Stamp


# U.S. PUBLIC LAND SURVEY MONUMENT RECORD

**Note:** This form is intended and designed to fulfill all requirements of Wisconsin Administrative Code, Chapter A-E 7.08 U.S. Public Land Survey Monument Record (3) (a) (b) (c) (d) (e) (f) (g) (h) (i). An additional sheet may be added if necessary to conform with said requirements.

(a) Corner location: Township 35 North  
 Range 9 East/West

Town/City/Village Enterprise

County Oneida

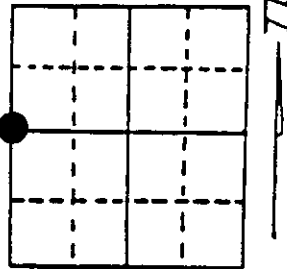

Section 30

(b) (f) (g) (h) Description of monument found at this corner and if it was accepted, state all evidence (material, testimonial, occupational, plats, records, other monuments) used as a basis for accepting. If not accepted or if nothing was found, state evidence used as basis for establishing location. If reestablished through lost corner proportionate methods, indicate all monuments, distances and directions used to establish. Indicate type of monument found or set and sign post.


- 1859 - Hiram Fellows established this corner and set a wood post with two BTs:  
 16" Birch, S32°E, 16 Lks (10.56')      12" Lynn, N35°W, 15 Lks (9.9')
- 3/17/1936 - Maine found original Birch BT - dead. Restored corner by placement of a  
 2" x 60" iron pipe with brass cap and two BTs:  
 8" Sugar Maple, S48½°W, 34 Lks (22.44')  
 12" Hemlock, S39°E, 81 Lks (53.46')
- 2/14/1979 - Joe Kirby subdivided Section 25, T35N, R8E and from plat of survey on file  
 in the Tax Listers Office of Lincoln County; Kirby made two new BTs:  
 7" Sugar Maple, S82°W, 25.8'      7" Elm, N35°W, 18.8'
- 3/21/1993 - Maines monument has been pulled up and is leaning against a tree. It needs  
 to be reset from above information when frozen ground thaws.
- 4/5/1993 - Milo E. Stefan reset 2" x 60" iron pipe/brass cap and took new bearings and  
 measurements.

This document replaces the one I filed in January 1990, Document #

(c) (d) (e) Plan view of corner with ties to at least 4 witness monuments. If in disagreement with previously established corner, show the distances between the two corners and also indicate the ties to the disputed corner.

- 1) 2" x 60" iron pipe/brass cap
- 2) 8" Elm (dead), N35°W, 18.8'
- 3) 8" Sugar Maple, S82°W, 25.8' ) Kirby 1979
- 4) 6" Sugar Maple, N68°E, 12.3'
- 5) 6" White Ash, S30°E, 23.83'
- 6) 5" Sugar Maple, S48°W, 31.06'
- 7) 4" Black Ash, N12°W, 32.84'
- 8) Green and white post, SW, 3.5'
- 9) Plastic sign post, North, .5'


Distances are to nail in side of BTs.  
 BT stump blaze scribed "BT".

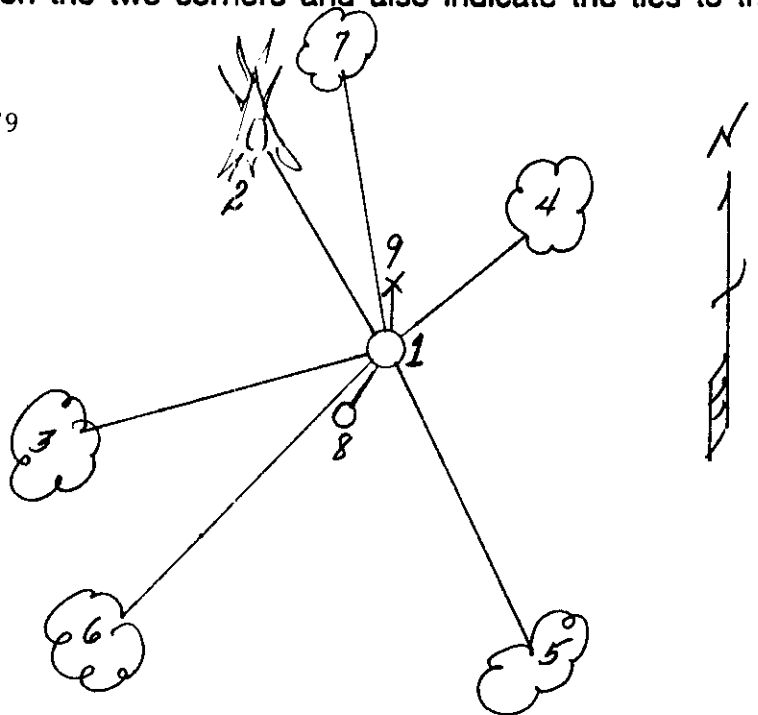

(i) I, Milo E. Stefan  
 (type or print name) certify that the corner location on this record was determined by me or under my direction and control and that this U.S. Public Land Survey Monument Record is correct and complete to the best of my knowledge and belief.

Milo E. Stefan  
 Signature

April 6, 1993  
 Date

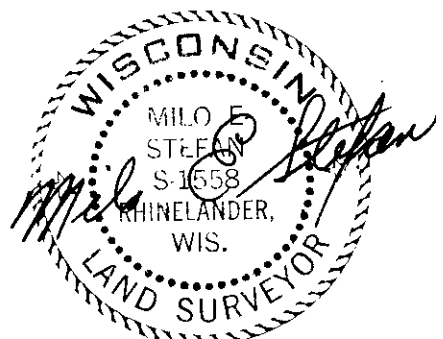

Index No. T-1

3508257000

Stamp