

State of Wisconsin



Resident witnesses:

CERTIFIED LAND CORNER RESTORATION

History of original corner establishment:

*Corner from
Lansford etc.*

Index No. 2-1

35-9



Description of corner evidence found:

2" iron pipe with brass cap, on stone cast and painted white with green top, 50" 31 1/2".
1 1/2" yellow birch 5 1/2" 20 1/2".

Description of monument and accessories I established to perpetuate the original location of this corner.

NEW MARKS

1 1/2" Cedar 55 1/2" 30 1/2"
1 1/2" Cedar 53 1/2" 33 1/2"
1 1/2" Yellow Birch 53 1/2" 30 1/2"

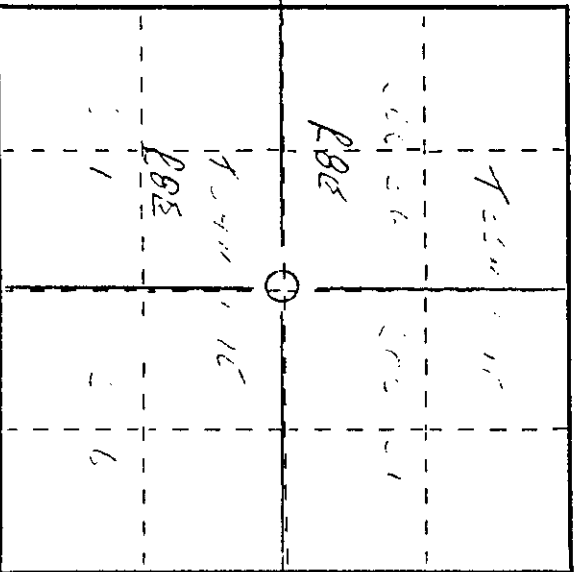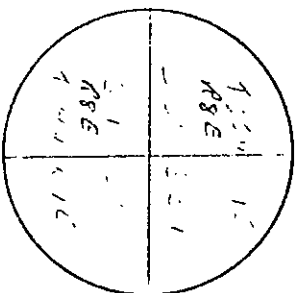

○ = Corner monument restored.







U.S. PUBLIC LAND SURVEY MONUMENT RECORD

Note: This form is intended and designed to fulfill all requirements of Wisconsin Administrative Code, Chapter A-E 5.02, U.S. Public Land Survey Monument Record (3) (a) (b) (c) (d) (e) (f) (g) (h) (i). An additional sheet may be added if necessary to conform with said requirements.

(a) Corner location: Township 35 North
 Range 9 East/West
 Town/City/Village Enterprise
 County Oneida

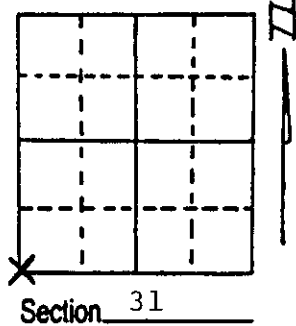


(b) (f) (g) (h) Description of monument found at this corner and if it was accepted, state all evidence (material, testimonial, occupational, plats, records, other monuments) used as a basis for accepting. If not accepted or if nothing was found, state evidence used as basis for establishing location. If reestablished through lost corner proportionate methods, indicate all monuments, distances and directions used to establish.

July 3, 1859 by Hiram C. Fellows ran west between sections 6 and 31, T34-35N, R9E and at 81.12 chains fell at post. This was temporary post as set from south. These notes are not in Oneida County that I could find.
 July 19, 1935 by V. Maine, set official brass cap on iron pipe from original BT, 10" Birch (dead) N51°E, 15 links (9.90') and made new BTs:
 22" Yellow Birch, S31°E, 52 1/2 links (34.65')
 14" Yellow Birch, N80°W, 49 3/4" (32.84')
 February 12, 1988 Milo E. Stefan found brass cap on iron pipe (screw-on type - pipe cap 2"):
 A) 24" Yellow Birch, S31°E, 34.65' (some of BT scribe present)
 B) 14" Yellow Birch, snag, N80°W, 33.65' (scribing present)
 C) 4" Yellow Birch, (Dead) N44°E, 9.45' (BT scribe only)
 D) 6" Cedar, S28°E, 32.45' (Beaver blaze at DBH and BT scribed)
 E) 6" Cedar snag, S61°W, 30.70' (Beaver blaze at DBH and BT scribed)

(c) (d) (e) Plan view of corner with ties to at least 4 witness monuments. If in disagreement with previously established corner, show the distances between the two corners and also indicate the ties to the disputed corner.

- 1) Brass cap on 2" iron pipe, deep in swamp, 2" above ice.
- 2) 6" Cedar, N12°E, 75.05' (T35N R9E S31 BT)
- 3) 12" White Pine, N29°W, 57.03' (T35N R8E S36 BT)
- 4) 24" Yellow Birch, S31°E, 34.65' (Maine's BT - 1935)
- 5) 6" Cedar, S28°E, 32.45' (By unknown surveyor)
- 6) Plastic sign post

Distances measured to nail in side of BTs.

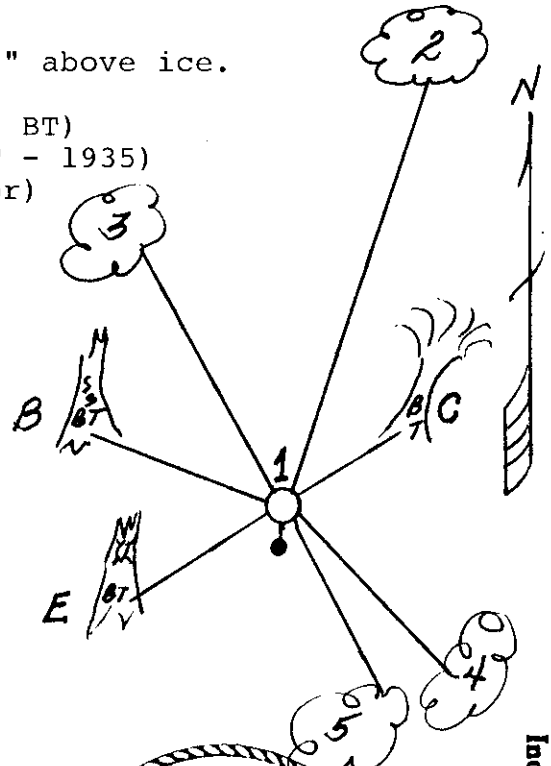

(i) I, Milo E. Stefan
 (type or print name) certify that the corner location on this record was determined by me or under my direction and control and that this U.S. Public Land Survey Monument Record is correct and complete to the best of my knowledge and belief.

Milo E. Stefan 2/26/88
 Signature Date



Index No. Z-1