

CERTIFIED LAND CORNER RESTORATION



Index No. **B-1**

State of Wisconsin } ss.
 County of Oneida

I, Phillip T. Hansen, do hereby certify that on the 29th day of March, 1976, I found evidence of the N 1/16 corner of Section 1 and 6 Township 35 North, Range 9 and 10 East, Fourth Principal Meridian, as described hereon; and that from this evidence I established a new monument and accessories as described hereon to perpetuate the original location of this corner.

Resident witnesses:

- Glen Barker
- Jim Claffin
- Herb Wagoner

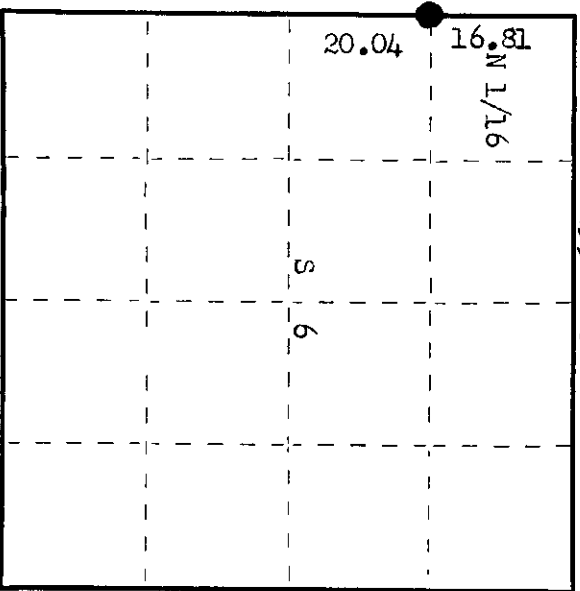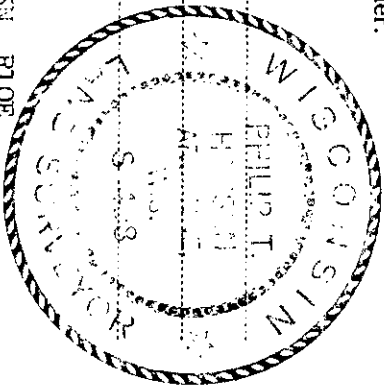

○ = Corner monument restored.

History of original corner establishment: Corner established by ripco surveyors (Orivas). Ran random line N 7° 00' 06" W, to point 70.2 lks west of section corner. At 30.85 chains - corrected and set N 1/16 corner 20.04 chains north at 1/4 corner. Marked Y. Birch 17" 560° 11 1/2 lks, cedar 9" 562° W 1.79 chains. Corrected bearing N 5° 54' 40" W.

Description of corner evidence found: Recovered a 1" aluminum pipe with cap stamped. Also a 6" squared cedar scribed N 1/16 - N 1/16. Recovered OBT - Y. Birch 17" 566° 11.5 lks (dying) scribed 35 R9E S6, T35N 9E T35N 10E N 1/16 BT. No trace of 9" cedar.

51 N 1/16
 56 Ripco

Description of monument and accessories I established to perpetuate the original location of this corner. Reset Ripco's pipe as it was only about 12" in ground and leaning. Monument projects 18" above ground. OBT - Sugar 12" 578° 75.3 lks scribed 1/16 BT. Hemlock 12" 429° W 2.117 chains. scribed 1/16 BT. Corner sets approximately 1.5 chains north of OTH - "G" Pipe and BTs painted blue.

Dated at Rhineland, Wis., this 19th day of May, 1976

Signature *Phillip T. Hansen* Title Registered Land Surveyor Registration No. 5-498
 (County Surveyor, Registered Land Surveyor, or other duly authorized official)

Office of Register of Deeds, County of Oneida, 10th day of June, 1976. I hereby certify that the within instrument was filed in this office for record on the 20th day of June, 1976 at 2:00 o'clock P.M.

George K. Hansen
 (Register of Deeds)

By _____ Deputy

3509013000