
iole:	This form is intended and designed to fulfill all requirements of Wisconsin Administrative Code, Chapter A-E 7.08 U	IS
	Public Land Survey Monument Record (3) (a) (b) (c) (d) (e) (f) (g) (h) (i). An additional sheet may be added if necessary	v to
	conform with said requirements	, •

				•	
(a)	Corner	location:	Township_	35	_North

Danaa	q	C	
Range	,	_East∕Wes	T

Town/City/Village	Enterprise	
County	Oneida .	

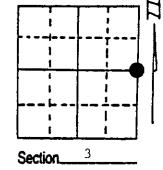


(b) (f) (g) (h) Description of monument found at this corner and if it was accepted, state all evidence (material, testimonial, occupational, plats, records, other monuments) used as a basis for accepting. If not accepted or if nothing was found, state evidence used as basis for establishing location. If reestablished through lost corner proportionate methods, indicate all monuments, distances and directions used to establish. Indicate type of monument found or set and sign post.

```
1864 - James Nowlin established this corner and set a wood post with two BTs:
10" Hemlock, S58°E, 6 Links
                                     18" Pine, N58°W, 23 Links
```


- 9/9/1936 Maine found original stake and stub of pine BT. He set a 2 1/4" x 60" iron pipe with brass cap and two references: 22" White Pine Stump, S22°W, 34 1/2 Links 5' x 8' Gray boulder, S60°W, 43 1/2 Links
- 11/15/1989 Milo E. Stefan found monument as set by Maine in good condition. White Pine Stump nearly rotted away. 5' x 8' x 4' high slate gray boulder with "X BT" very clear. We made new BTs and set plastic sign post.

(c) (d) (e) Plan view of corner with ties to at least 4 witness monuments. If in disagreement with previously established corner, show the distances between the two corners and also indicate the ties to the disputed corner.

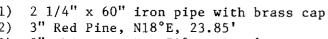

- 8" White Birch, S73°E, 13.55'
- 8" White Birch, S9°E, 17.72'
- 5' x 8' x 4' Gray Boulder, S60°W, 28.54'
- Plastic sign post next to monument

Distances to nail in side of BTs

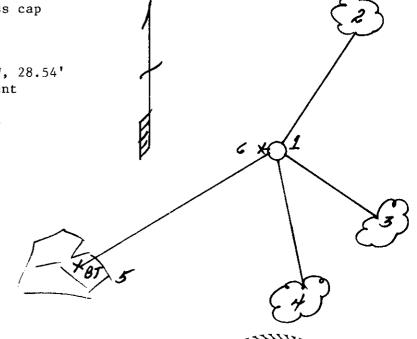

Milo E. Stefan (i) I._

(type or print name) certify that the corner location on this record was determined by me or under my direction and control and that this U.S. Public Land Survey Monument Record is correct and complete to the best of my knowledge and belief.

Signature

11/17/89

Date

