


U.S. PUBLIC LAND SURVEY MONUMENT RECORD

Note: This form is intended and designed to fulfill all requirements of Wisconsin Administrative Code, Chapter A-E 7.08 U.S. Public Land Survey Monument Record (3) (a) (b) (c) (d) (e) (f) (g) (h) (i). An additional sheet may be added if necessary to conform with said requirements.

(a) Corner location: Township 35 North
 Range 9 East/West

Town/City/Village Enterprise

County Oneida

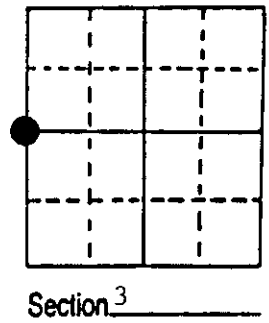

(b) (f) (g) (h) Description of monument found at this corner and if it was accepted, state all evidence (material, testimonial, occupational, plats, records, other monuments) used as a basis for accepting. If not accepted or if nothing was found, state evidence used as basis for establishing location. If reestablished through lost corner proportionate methods, indicate all monuments, distances and directions used to establish. Indicate type of monument found or set and sign post.

1864 - James Nowlin established this corner at 40.9 chains, set wood post and two BTs:
 7" W. Pine, S33°E, 25 Links 8" W. Pine, S55°W, 8 Links

9/8/1936 - Maine found stake and both original BTs are dead. He set a 2" x 60" iron pipe with brass cap and two new BTs:
 20" W. Pine, S8°E, 1.60 Chains 10" W. Pine Stub, N69°E, 43 Links


10/11/1991 - Milo E. Stefan found monument set by Maine rusted off and lying below moss and water. Maine's BTs are nearly gone - we placed a new aluminum monument, made new references and set plastic sign post.

Corner is in small wet swail. Timber all cut spring of 1990. We measured distance from Section Corner one-half mile southerly through South Sixteenth by Maine.

(c) (d) (e) Plan view of corner with ties to at least 4 witness monuments. If in disagreement with previously established corner, show the distances between the two corners and also indicate the ties to the disputed corner.

- 1) 2" x 30" aluminum monument.
- 2) 14" Hemlock, N16°E, 107.45'.
- 3) 6" White Pine, N77°E, 79.29'.
- 4) 3' x 4.5' x 1.5' high chalk colored boulder; "X" chiseled on high point, S55°E, 31.66'.
- 5) 16" Hemlock, S30°E, 124.53'.
- 6) 20" White Pine Stump, S8°E, 105.92'.
- 7) Plastic sign post, NW, .8'.

Distance to nail in side of BTs.
 Stump blaze scribed "BT".

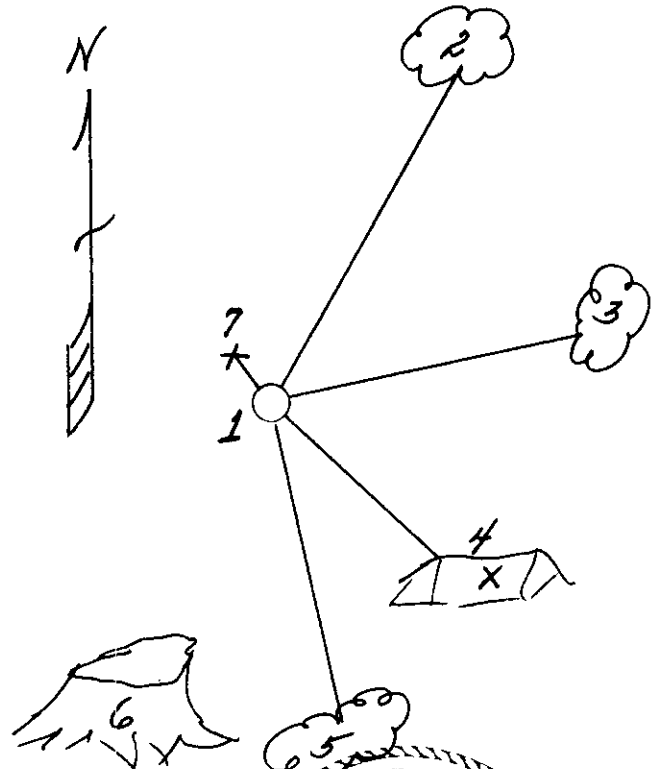

(i) I, Milo E. Stefan
 (type or print name) certify that the corner location on this record was determined by me or under my direction and control and that this U.S. Public Land Survey Monument Record is correct and complete to the best of my knowledge and belief.

Milo E. Stefan
 Signature

October 14, 1991
 Date



Stamp

Index No. C-13