U.S. PUBLIC LAND SURVEY MONUMENT RECORD

Note: This form is intended and designed to fulfill all requirements of Wisconsin Administrative Code, Chapter A-E 7.08 U.S. Public Land Survey Monument Record (3) (a) (b) (c) (d) (e) (f) (g) (h) (i). An additional sheet may be added if necessary to conform with said requirements.

(a) Corner location: Township 35 North

Range 9 East/~~West~~

Town/City/Village Enterprise

County Oneida

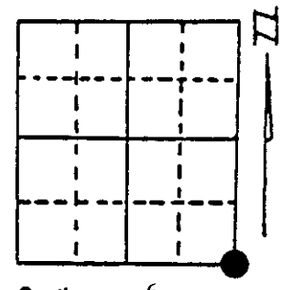

Section 6

(b) (f) (g) (h) Description of monument found at this corner and if it was accepted, state all evidence (material, testimonial, occupational, plats, records, other monuments) used as a basis for accepting. If not accepted or if nothing was found, state evidence used as basis for establishing location. If reestablished through lost corner proportionate methods, indicate all monuments, distances and directions used to establish. Indicate type of monument found or set and sign post.

10/30/1864 - James Nowlin established corner and set a wood post and two BTs and two witness trees:
10" Maple, N25°W, 10 Links — 12" Fir) No bearing or distances
13" Aspen, S37°E, 28 Links — 9" Hemlock) called

12/7/1908 - Vaughn found 16" Hemlock stub (witness tree) and restored corner. New BT: 18" White Pine, S20°E, 19 Links

7/24/1935 - Maine found Vaughn's BT and restored corner by setting a 2 1/4" x 60" iron pipe/brass cap and called new bearing objects:
20" Hard Maple, N81°E, 91 1/4 Links
18" White Pine Stump (Vaughns), S16°E, 19 1/4 Links
6' x 6' Gray Boulder, North, 60 Links

11/4/1989 - Milo E. Stefan found Maine's monument and boulder in good condition. Maple gone, Pine Stump very decayed. Made three new BTs.

(c) (d) (e) Plan view of corner with ties to at least 4 witness monuments. If in disagreement with previously established corner, show the distances between the two corners and also indicate the ties to the disputed corner.

1) 2 1/4" x 60" Brass capped iron pipe
2) 6' x 6' x 5' high, gray granite boulder north, 60.2 feet
3) 6" Basswood, N58°E, 18.65 feet
4) 6" Red Maple, S48°E, 19.38 feet
5) 7" Sugar Maple, S63°W, 15.38 feet
6) Plastic sign post next to monument

Distances to nails in side of BTs

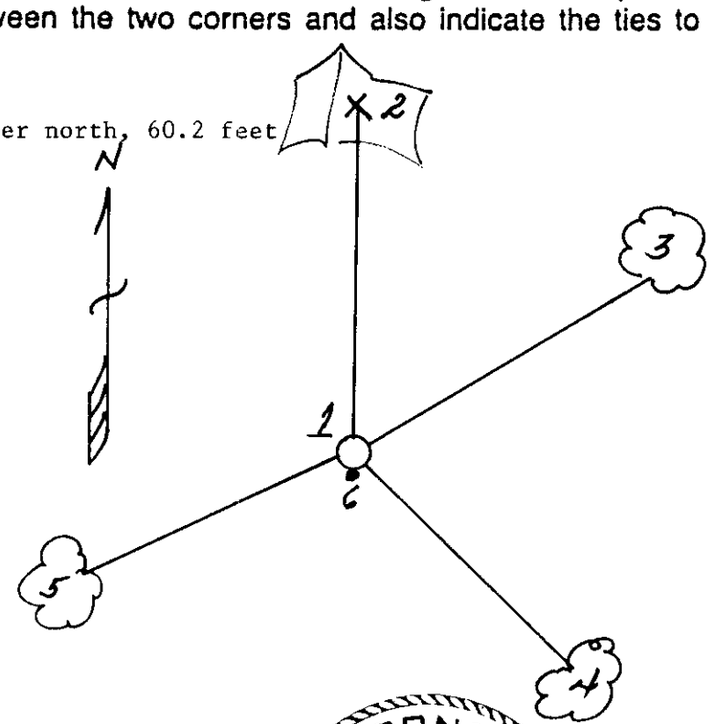

(i) I, Milo E. Stefan (type or print name) certify that the corner location on this record was determined by me or under my direction and control and that this U.S. Public Land Survey Monument Record is correct and complete to the best of my knowledge and belief.

Milo E. Stefan — 11/5/89

Signature — Date

WISCONSIN MILO E. STEFAN S-1558 RHINELANDER, WIS. LAND SURVEYOR

Index No. E-5