

U.S. PUBLIC LAND SURVEY MONUMENT RECORD


Note: This form is intended and designed to fulfill all requirements of Wisconsin Administrative Code, Chapter A-E 7.08 U.S. Public Land Survey Monument Record (3) (a) (b) (c) (d) (e) (f) (g) (h) (i). An additional sheet may be added if necessary to conform with said requirements.

(a) Corner location: Township 35 North

Range 9 East/West

Town/City/Village Enterprise

County Oneida

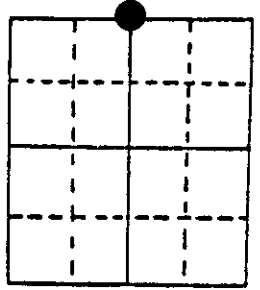

Section 18

(b) (f) (g) (h) Description of monument found at this corner and if it was accepted, state all evidence (material, testimonial, occupational, plats, records, other monuments) used as a basis for accepting. If not accepted or if nothing was found, state evidence used as basis for establishing location. If reestablished through lost corner proportionate methods, indicate all monuments, distances and directions used to establish. Indicate type of monument found or set and sign post.

1864 - James Nowlin established this corner and set a wood post with two BTs:
 7" Spruce, N34°E, 25 Links 8" Maple, S12°W, 10 Links


9/1/1936 - Maine found old stake in mound of stone and restored corner by placement of a
 2 1/4" x 60" iron pipe/brass cap and two new BTs:
 10" Hemlock, S54°E, 38 Links 10" Hemlock, S78°E, 54 1/2 Links

12/6/1989 - Milo E. Stefan found Maine's monument and Hemlock S78°E, 54 1/2 links with
 stump blaze overgrown. We made three new BTs and set plastic sign post.
 Corner is in swamp recently flooded by beaver with timber all dead. BTs are
 just south of swamp edge.

(c) (d) (e) Plan view of corner with ties to at least 4 witness monuments. If in disagreement with previously established corner, show the distances between the two corners and also indicate the ties to the disputed corner.

- 1) 2 1/4" x 60" iron pipe with brass cap
- 2) 12" Hemlock, S78°E, 54 1/2 Links (Maine)
- 3) 6" Cedar, S57°E, 30.86'
- 4) 6" Black Spruce, S25°E, 34.22'
- 5) 12" Hemlock, S2°W, 82.40'
- 6) Plastic sign post next to monument

Distances to nail in side of trees.
 BT stumps scribed "BT".

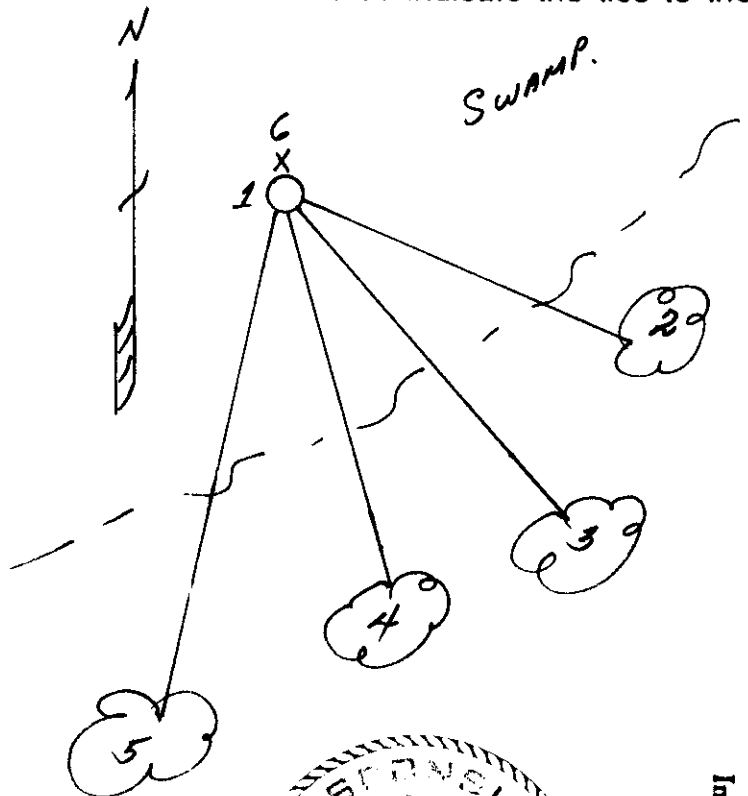

(i) I, Milo E. Stefan

(type or print name) certify that the corner location on this record was determined by me or under my direction and control and that this U.S. Public Land Survey Monument Record is correct and complete to the best of my knowledge and belief.

Milo E. Stefan
 Signature

12/6/89
 Date



Index No. J-3