

U.S. PUBLIC LAND SURVEY MONUMENT RECORD


Note: This form is intended and designed to fulfill all requirements of Wisconsin Administrative Code, Chapter A-E 7.08 U.S. Public Land Survey Monument Record (3) (a) (b) (c) (d) (e) (f) (g) (h) (i). An additional sheet may be added if necessary to conform with said requirements.

(a) Corner location: Township 35 North

Range 9 East/West

Town/City/Village Enterprise

County Oneida

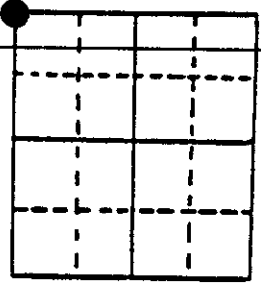

Section 14

(b) (f) (g) (h) Description of monument found at this corner and if it was accepted, state all evidence (material, testimonial, occupational, plats, records, other monuments) used as a basis for accepting. If not accepted or if nothing was found, state evidence used as basis for establishing location. If reestablished through lost corner proportionate methods, indicate all monuments, distances and directions used to establish. Indicate type of monument found or set and sign post.

1864 - James Nowlin established this corner and set a wood post with two BTs and two witness trees:

10" Tamarack, N22°E, 11 Links	8" Tamarack, S35°W, 18 Links
6" Tamarack	6" Tamarack

8/13/1936 - Maine found old squared post and stub of northeast BT. He set a 2 1/4" x 60" iron pipe monument and made two BTs:


14" Cedar, N39°E, 81 Links	12" Cedar, S3°E, 94 1/2 Links
----------------------------	-------------------------------

11/27/1989 - Milo E. Stefan found Maine's monument in good condition, northeast BT okay. Southeast BT fallen. We made three new BTs and set plastic sign post.

(c) (d) (e) Plan view of corner with ties to at least 4 witness monuments. If in disagreement with previously established corner, show the distances between the two corners and also indicate the ties to the disputed corner.

- 1) 2 1/4" x 60" iron pipe/brass cap
- 2) 10" Cedar, N8°E, 37.87'
- 3) 16" Cedar, N39°E, 53.95' (Maines)
- 4) 6" Black Spruce, S63°W, 42.36'
- 5) 13" Tamarack, N28°W, 13.03'
- 6) Plastic sign post, southeast, 1.6' (old post tied to it)

Distances to nail in side of BTs.
Stump blaze scribed "BT".

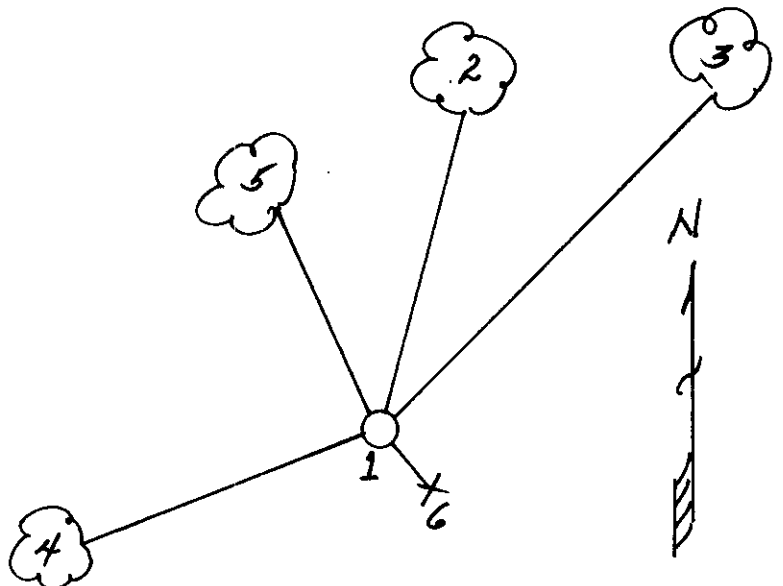

(i) I, Milo E. Stefan
(type or print name) certify that the corner location on this record was determined by me or under my direction and control and that this U.S. Public Land Survey Monument Record is correct and complete to the best of my knowledge and belief.



Milo E. Stefan
Signature

11/30/89
Date

Index No. 1-17