U.S. PUBLIC LAND SURVEY MONUMENT RECORD

Note: This form is intended and designed to fulfill all requirements of Wisconsin Administrative Code, Chapter A-E 7.08 U.S Public Land Survey Monument Record (3) (a) (b) (c) (d) (e) (f) (g) (h) (i). An additional sheet may be added if necessary t conform with said requirements.

(a) Corner location: Township 35 North

Range 9 East/~~West~~

~~Town/City/Village~~ Enterprise

County Oneida

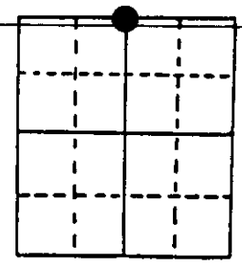

Section 13

(b) (f) (g) (h) Description of monument found at this corner and if it was accepted, state all evidence (material, testimonial, occupational, plats, records, other monuments) used as a basis for accepting. I not accepted or if nothing was found, state evidence used as basis for establishing location. I reestablished through lost corner proportionate methods, indicate all monuments, distances and directions used to establish. Indicate type of monument found or set and sign post.

1864 - James Nowlin established this corner and set a wood post with two BTs:
9" Hemlock, S30°W, 25 Links 10" Birch, N69°W, 10 Links

11/23/1990 - Milo E. Stefan found 3/4" x 42" iron pipe marking corner. Remains of original Birch BT, N69°W, 6.6' still here, roots and stump hole. Hemlock BT left no trace.

Swamp call East 2.0 chains is within reason. Newly painted blue and blazed boundary lines south and west. We replaced iron pipe and made new BTs and set plastic sign post.

(c) (d) (e) Plan view of corner with ties to at least 4 witness monuments. If in disagreement with previously established corner, show the distances between the two corners and also indicate the ties to the disputed corner.

1) 2" x 36" aluminum county monument
2) 10" Sugar Maple, N25°E, 10.00 feet
3) 10" Hemlock, S23°E, 16.68 feet
4) 12" Hemlock, S48°W, 26.69 feet
5) 6" Sugar Maple, N25°W, 7.27 feet
6) Plastic sign post, SE, .8 feet

Distances to nail in side of BTs.
Stump blazes scribed "BT".

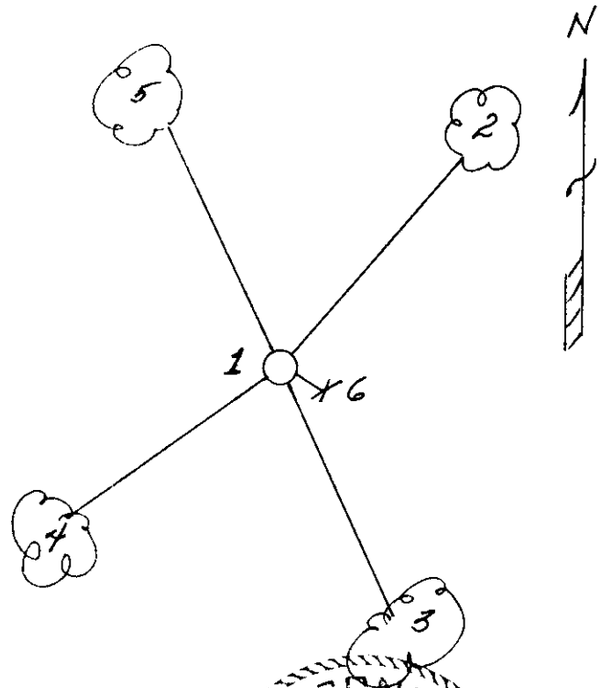

REGISTER OF DEEDS OFFICE
ONEIDA COUNTY, WIS
FILED
DEC 12 1990
At _____ O'Clock _____ M
THOMAS H. LEIGHTON
REGISTER OF DEEDS

(i) I, Milo E. Stefan (type or print name) certify that the corner location on this record was determined by me or under my direction and control and that this U.S. Public Land Survey Monument Record is correct and complete to the best of my knowledge and belief.

Milo E. Stefan 12/5/90

Signature Date

WISCONSIN MILO E. STEFAN S-1578 RHINELANDER, WIS. LAND SURVEYOR

Stamp

Index No. J-23