

CERTIFIED LAND CORNER RESTORATION

Index No. **G-1**

State of Wisconsin

County of Oneida } ss.

I Phillip T. Hansen, do hereby certify that on the 20th day of March, 1978, I found evidence of the Quarter corner of Section 7 & 12

Township 35, North, Range 9 & 10, Fourth Principal Meridian,



as described hereon; and that from this evidence I established a new monument and accessories as described hereon to perpetuate the original location of this corner.

Resident witnesses:

Glen Barker

Jim Clafin

Herb Wagoner

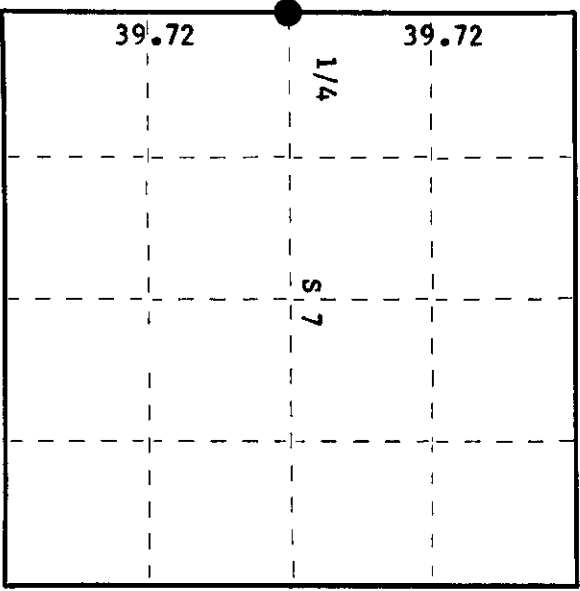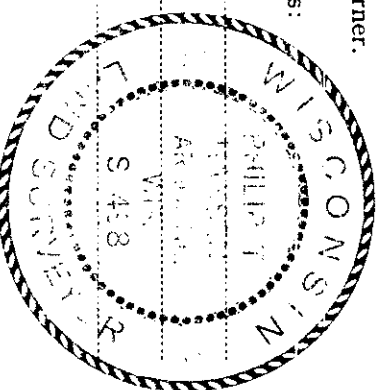

○ = Corner monument restored.

History of original corner establishment:

Original corner established by Hiram C. Fellows, Deputy Surveyor, in 1859, from which Hemlock 12" bears N40°E, 5 links and Hemlock 9" bears N30°W, 7 links. H.C. Lawrence, Registered Land Surveyor, re-established this corner in 1946. From recovered section corner 7, 18, 13, 12, ran random line N 2° W magnetic, a distance of 79.44 chains to close out 57 links east of section corner. Set 1/4 corner by proportionate measurement at 39.72 chains intermediate, 28 1/2 links west of random. Marked NBR's - Sugar 24" N28°W, 70 links and Yellow Birch 6" S50°E, 72 links.

Description of corner evidence found:

Recovered Maine's 2 1/2" iron pipe with screw in brass cap projecting 8" above ground in very poor condition. Cap stamped: R9 R10  
 Searched for, but was unable to find evidence of H.C. Lawrence's cedar post. T35  
 Recovered OBT - Sugar 24" N28°W, 70 links, now a cut off and rotted stump. S12 1/4 S7  
 Recovered Maine's Yellow Birch 6" S50°E, 72 links, now a cut off stump.

Description of monument and accessories I established to perpetuate the original location of this corner.

As the condition of the iron pipe was very poor (bent and rusty), replaced it with new 2 1/2" Bernitsen A-1 Federal Monument projecting 8" above ground. Cap stamped:

- Marked NBR's - Sugar 7" N84°E, 18.2 links S498  
 Sugar 10" S38°E, 24.5 links T35N  
 Maple 6" S24°W, 52.2 links R  
 Maple 12" N70°W, 42.4 links S12 S7  
 all scribed 1/4 BT. E 10  
 E 1978

Dated at Rhinelander, Wis., this 5th day of April, 1978

Signature Phillip T. Hansen Title Registered Land Surveyor Registration No. S-498  
 (County Surveyor, Registered Land Surveyor, or other duly authorized official)

Office of Register of Deeds, County of Oneida  
 Instrument was filed in this office for record on the 17th day of April, 1978  
 at 7:50 o'clock P. M.

Doree Burgess Kuhn  
 (Register of Deeds)

By \_\_\_\_\_ Deputy

3509/2200