

CERTIFIED LAND CORNER RESTORATION



Index No. F-1

State of Wisconsin

County of Oneida } ss.

I Phillip T. Hansen, do hereby certify that on the 20th day of March, 19 78, I found evidence of the N 1/16 corner of Section 12 & 7 Township 35, North, Range 9 & 10 East, Fourth Principal Meridian, as described hereon; and that from this evidence I established a new monument and accessories as described hereon to perpetuate the original location of this corner.

Resident witnesses:
Glen Barker
Jim Claflin
Herb Wagoner

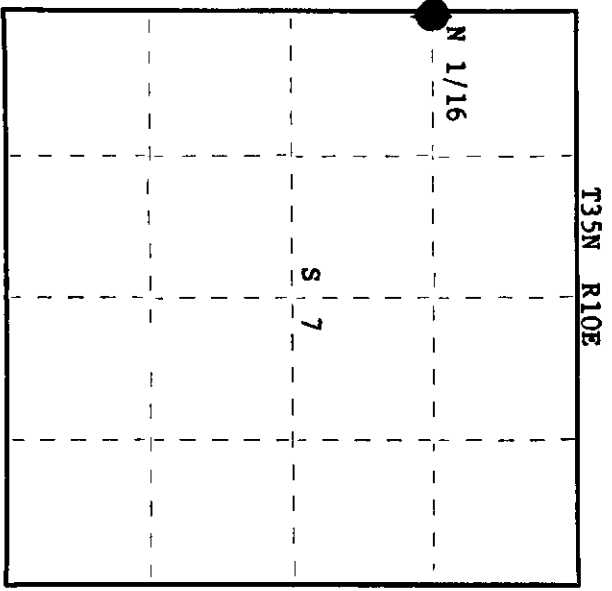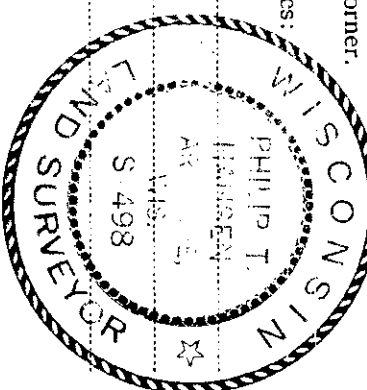

○ = Corner monument restored.

History of original corner establishment:

Corner established by V. Maine, county surveyor. Set N 1/16 at 43 links west of random line at 59.58 chains north of corner. Made Br's visible - cedar 6" N 86° W, 21 links; cedar 8" east 25 links. Set 4" cedar post for N 1/16.

Description of corner evidence found:

Recovered the point of Maine's cedar post. Recovered OBT's - cedar 6" N 86° W, 21 links, now down and rotted, some scribe marks visible. Cedar 8" (10") east 25 links, scribed 1/85.

Description of monument and accessories I established to perpetuate the original location of this corner.

Replaced post point with a 1 1/2" iron pipe with brass cap, stamped: Projects 16" above ground.

NBT - cedar 8" N 28° E, 35.6 links scribed 1/16 BT.

S498
T35N R
9 N 1/16 121 7 R
E E
CPI-1978 E

Dated at Rhineland, Wis., this 5th day of April, 19 78

Signature Phillip T. Hansen Title Registered Land Surveyor Registration No. S-498
(County Surveyor, Registered Land Surveyor, or other duly authorized official)

Office of Register of Deeds, County of Oneida. I hereby certify that the within instrument was filed in this office for record on the 10th day of April, 19 78 at 10:30 o'clock A. M.

Dona DeWeger Kuehn
(Register of Deeds)

By _____ Deputy

3509123000