


# U.S. PUBLIC LAND SURVEY MONUMENT RECORD

**Note:** This form is intended and designed to fulfill all requirements of Wisconsin Administrative Code, Chapter A-E 7.08 U.S. Public Land Survey Monument Record (3) (a) (b) (c) (d) (e) (f) (g) (h) (i). An additional sheet may be added if necessary to conform with said requirements.

(a) Corner location: Township 35 North  
 Range 9 East/West

Town/City/Village Enterprise  
 County Oneida

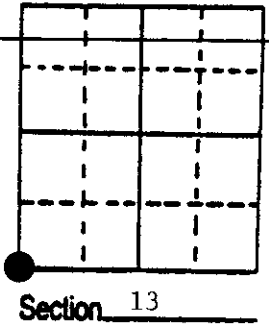

(b) (f) (g) (h) Description of monument found at this corner and if it was accepted, state all evidence (material, testimonial, occupational, plats, records, other monuments) used as a basis for accepting. If not accepted or if nothing was found, state evidence used as basis for establishing location. If reestablished through lost corner proportionate methods, indicate all monuments, distances and directions used to establish. Indicate type of monument found or set and sign post.

1864 - James Nowlin established this corner and set wood post with two BTs and two witness trees:  
 12" Tamarack, S77°E, 12 Links      10" Tamarack, N5°W, 16 Links  
 7" Tamarack      9" Tamarack


1932 or 33 - Hall found old post and both BTs broken off. Scribing plain on north one. He made two new references:  
 9" Cedar Stub, S44°E, 56 1/4 Links, 9" Cedar Stub, N87°W, 51.8 Links

11/16/1989 - Milo E. Stefan found Hall's monument in good condition. All BTs nearly gone. We made four new BTs and set plastic sign post.

(c) (d) (e) Plan view of corner with ties to at least 4 witness monuments. If in disagreement with previously established corner, show the distances between the two corners and also indicate the ties to the disputed corner.

- 1) 6" x 6" x 30" concrete monument
- 2) 6" Black Spruce, N56°E, 20.88'
- 3) 9" White Birch, S2°W, 6.22'
- 4) 8" Black Spruce, N78°W, 20.82'
- 5) 8" White Spruce, N8°W, 32.58'
- 6) Plastic sign post on north side of monument

Distances to nail in side of BTs.

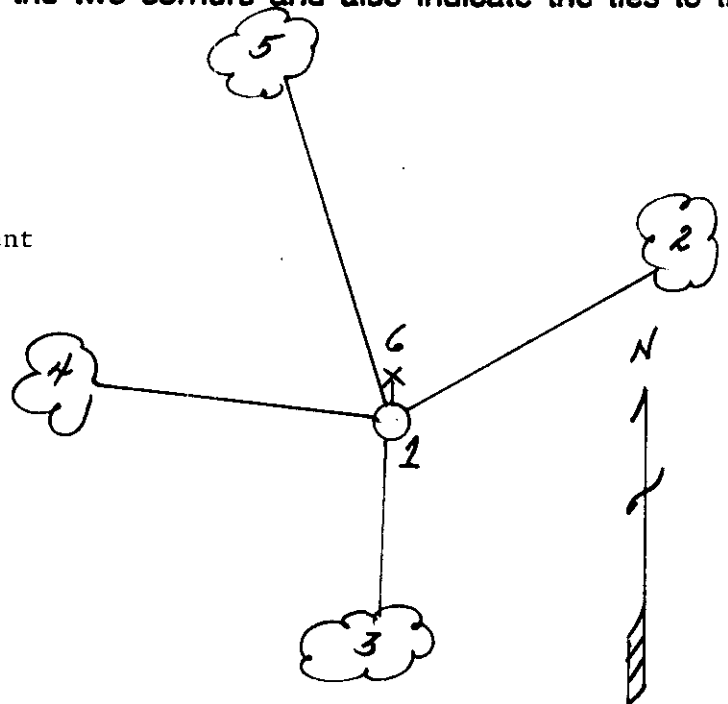

(i) I, Milo E. Stefan  
 (type or print name) certify that the corner location on this record was determined by me or under my direction and control and that this U.S. Public Land Survey Monument Record is correct and complete to the best of my knowledge and belief.

Milo E. Stefan      11/25/1989  
 Signature      Date



Index No. N-21

35-114-200