

U.S. PUBLIC LAND SURVEY MONUMENT RECORD


Note: This form is intended and designed to fulfill all requirements of Wisconsin Administrative Code, Chapter A-E 7.08 U.S. Public Land Survey Monument Record (3) (a) (b) (c) (d) (e) (f) (g) (h) (i). An additional sheet may be added if necessary to conform with said requirements.

(a) Corner location: Township 35 North

Range 9 East/West

Town/City/Village Enterprise

County Oneida

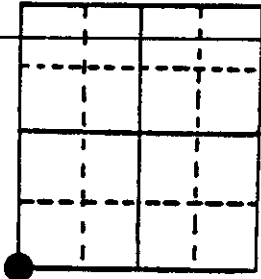

Section 14

(b) (f) (g) (h) Description of monument found at this corner and if it was accepted, state all evidence (material, testimonial, occupational, plats, records, other monuments) used as a basis for accepting. If not accepted or if nothing was found, state evidence used as basis for establishing location. If reestablished through lost corner proportionate methods, indicate all monuments, distances and directions used to establish. Indicate type of monument found or set and sign post.

1864 - James Nowlin established this corner and set a wood post with two BTs and two witness corners:
 15" Birch, N45°E, 38 Links 18" Pine, N72°W, 15 Links
 10" Birch 12" Tamarack


1932 or 33 - Hall found both original BTs and set a 6" x 6" x 30" concrete monument and three new BTs:
 9" White Pine, N74°E, 19.1 Links 9" White Pine, S40°E, 44.8 Links
 24" Pine Stump, N30°E, 82.7 Links

11/16/1989 - Milo E. Stefan found Hall's monument broken off and brass cap and top 8" about 2' from base. Both BTs alive. We placed a new aluminum monument, made two new BTs and set plastic sign post.

(c) (d) (e) Plan view of corner with ties to at least 4 witness monuments. If in disagreement with previously established corner, show the distances between the two corners and also indicate the ties to the disputed corner.

- 1) 2" x 30" aluminum monument
- 2) 14" White Pine, N74°E, 12.76'
- 3) 16" White Pine, S40°E, 28.97'
- 4) 10" Red Maple, S73°W, 10.29'
- 5) 10" Red Maple, N44°W, 39.12'
- 6) 24" Pine Stump, N30°E, 54.6'
- 7) Plastic sign post, south, 1.0'

Distances to nail in side of BTs.

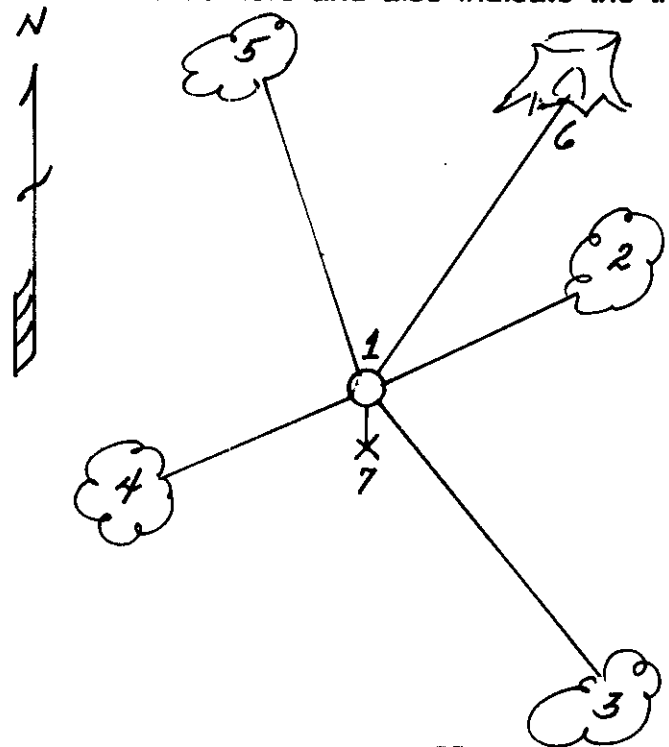

(i) I, Milo E. Stefan
 (type or print name) certify that the corner location on this record was determined by me or under my direction and control and that this U.S. Public Land Survey Monument Record is correct and complete to the best of my knowledge and belief.

Milo E. Stefan
 Signature

11/22/89
 Date

