


U.S. PUBLIC LAND SURVEY MONUMENT RECORD

Note: This form is intended and designed to fulfill all requirements of Wisconsin Administrative Code, Chapter A-E 7.08 U.S. Public Land Survey Monument Record (3) (a) (b) (c) (d) (e) (f) (g) (h) (i). An additional sheet may be added if necessary to conform with said requirements.

(a) Corner location: Township 35 North
 Range 9 East/West

Town/City/Village Enterprise

County Oneida

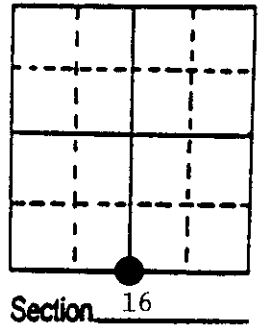


(b) (f) (g) (h) Description of monument found at this corner and if it was accepted, state all evidence (material, testimonial, occupational, plats, records, other monuments) used as a basis for accepting. If not accepted or if nothing was found, state evidence used as basis for establishing location. If reestablished through lost corner proportionate methods, indicate all monuments, distances and directions used to establish. Indicate type of monument found or set and sign post.

- 1864 - James Nowlin established this corner and set a wood post with two BTs:
 18" Sugar Maple, N25°E, 15 Links 20" Pine, S26°E, 16 Links
- 12/30/1909 - Vaughan found stumps of original BTs, set a new wood post and new BTs:
 24" W. Pine, N63°E, 22 Links 26" W. Pine, S26°E, 18 1/2 Links
 (original ?)
- 1/30/1990 - Milo E. Stefan and Rick Rowman pulled tape from Section Corner west and at 39.30 chains found two White Pine stumps that fit for Vaughan's BTs. Pulled East, to swamp, 5.0 chains and this conforms to Nowlins call in original notes.
 I, therefore, accept this evidence and restore this corner by placing a 2" x 30" aluminum monument, take new BTs and place a plastic sign post.

(c) (d) (e) Plan view of corner with ties to at least 4 witness monuments. If in disagreement with previously established corner, show the distances between the two corners and also indicate the ties to the disputed corner.

- 1) 2" x 30" Aluminum County Monument.
- 2) 24" White Pine Stump, N63°E, 14.5'
- 3) 26" White Pine Stump, S26°E, 12.25'
- 4) 8" Red Oak, S85°E, 56.10'
- 5) 5" Sugar Maple, S3°W, 40.88'
- 6) 6" Sugar Maple, S58°W, 47.02'
- 7) 6" Sugar Maple, N88°W, 31.13'
- 8) Plastic sign post next to monument

Distances to nail in side of BTs.
 BTs scribed "BT" in stump blaze.

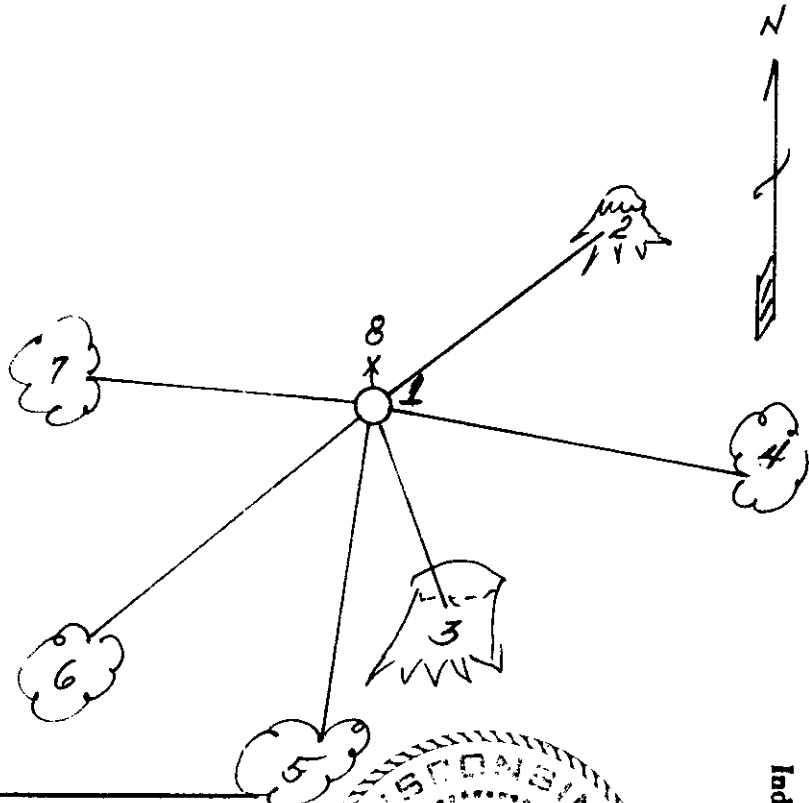

(i) I, Milo E. Stefan
 (type or print name) certify that the corner location on this record was determined by me or under my direction and control and that this U.S. Public Land Survey Monument Record is correct and complete to the best of my knowledge and belief.

Milo E. Stefan 2/2/90
 Signature Date



Stamp

Index No. N-11