U.S. PUBLIC LAND SURVEY MONUMENT RECORD

Note: This form is intended and designed to fulfill all requirements of Wisconsin Administrative Code, Chapter A-E 7.08 U.S Public Land Survey Monument Record (3) (a) (b) (c) (d) (e) (f) (g) (h) (i). An additional sheet may be added if necessary t conform with said requirements.

(a) Corner location: Township 35 North

Range 9 East/West

Town/City/Village Enterprise

County Oneida

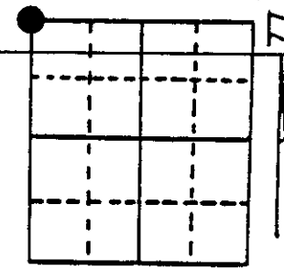

Section 20

(b) (f) (g) (h) Description of monument found at this corner and if it was accepted, state all evidence (material, testimonial, occupational, plats, records, other monuments) used as a basis for accepting. If not accepted or if nothing was found, state evidence used as basis for establishing location. If reestablished through lost corner proportionate methods, indicate all monuments, distances and directions used to establish. Indicate type of monument found or set and sign post.

1864 - James Nowlin established this corner and set a wood post with two BTs and one witness tree:
12" Birch, N21°E, 26 Links
10" Sugar, S31°W, 26 Links
12" Birch

1910 - Vaughn was here and made a new BT.

8/22/1935 - Maine found Vaughn's BT and restored corner by setting a 2 1/2" iron pipe/brass cap and new BTs:
14" Soft Maple, N25°E, 49 Links
16" Hemlock Stump, N66°E, 14 1/2 Links

11/28/1989 - Milo E. Stefan found Maine's monument on south edge of woods road, bent over and in poor condition. Hemlock stump is in road; soft maple is source of several Red Maple sprouts. We replaced the iron pipe with a 2" x 30" aluminum monument, made new BTs and set plastic sign post.

(c) (d) (e) Plan view of corner with ties to at least 4 witness monuments. If in disagreement with previously established corner, show the distances between the two corners and also indicate the ties to the disputed corner.

1) 2" x 30" aluminum monument
2) 3" Red Maple, N64°E, 24.66'
3) 11" Red Oak, S5°E, 15.43'
4) 10" Red Oak, N84°W, 4.13'
5) 4" Red Oak, N2°E, 27.82'
6) Plastic sign post, Southwest, 4.6'

Distances to nail in side of BTs
Stump blazes scribed "BT"

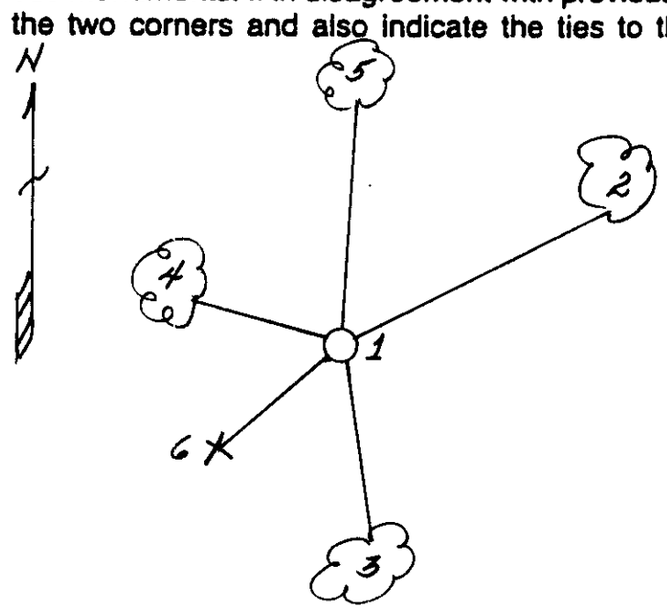

(i) I, Milo E. Stefan **(type or print name) certify that the corner location on this record was determined by me or under my direction and control and that this U.S. Public Land Survey Monument Record is correct and complete to the best of my knowledge and belief.**

Milo E. Stefan
Signature

11/29/89
Date

WISCONSIN
MILO E. STEFAN
S-1558
RHINELANDER, WIS.
LAND SURVEYOR

Index No. N-5