U.S. PUBLIC LAND SURVEY MONUMENT RECORD

Note: This form is intended and designed to fulfill all requirements of Wisconsin Administrative Code, Chapter A-E 7.08 U.S Public Land Survey Monument Record (3) (a) (b) (c) (d) (e) (f) (g) (h) (i). An additional sheet may be added if necessary to conform with said requirements.

(a) Corner location: Township 35 North

Range 9 East/West

Town/City/Village Enterprise

County Oneida

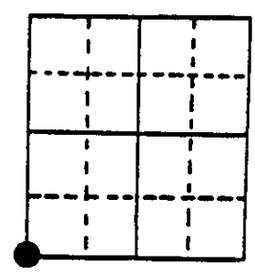

Section 20

(b) (f) (g) (h) Description of monument found at this corner and if it was accepted, state all evidence (material, testimonial, occupational, plats, records, other monuments) used as a basis for accepting. If not accepted or if nothing was found, state evidence used as basis for establishing location. If reestablished through lost corner proportionate methods, indicate all monuments, distances and directions used to establish. Indicate type of monument found or set and sign post.

1864 - James Nowlin established this corner and set a wood post with two BTs and two witness trees:

10" Ironwood, N26°W, 25 Links — 8" Ironwood, S59°W, 26 Links
16" W. Birch — 17" W. Birch

1/5/1910 - Vaughn was here and restored corner from original BTs.

8/17/1936 - Maine found Vaughn's BTs and restored corner by placing a 2 1/4" x 60" iron pipe/brass cap and marking a gray boulder, S37°E, 5 Links.

11/28/1989 - Milo E. Stefan found Maine's monument in good condition and boulder marked (S29' BT) in place. We made three new BTs and set plastic sign post.

(c) (d) (e) Plan view of corner with ties to at least 4 witness monuments. If in disagreement with previously established corner, show the distances between the two corners and also indicate the ties to the disputed corner.

1) 2 1/4" x 60" iron pipe with brass cap
2) 10" Red Maple, N48°E, 12.49'
3) 30" x 24" x 16" gray granite boulder S37°E, 5 Links
4) 8" Sugar Maple, N85°W, 20.88'
5) 6" Sugar Maple, N17°W, 20.61'
6) Plastic sign post, south, 1.2'

Distances to nail in side of BTs
Stump blaze scribed "BT"

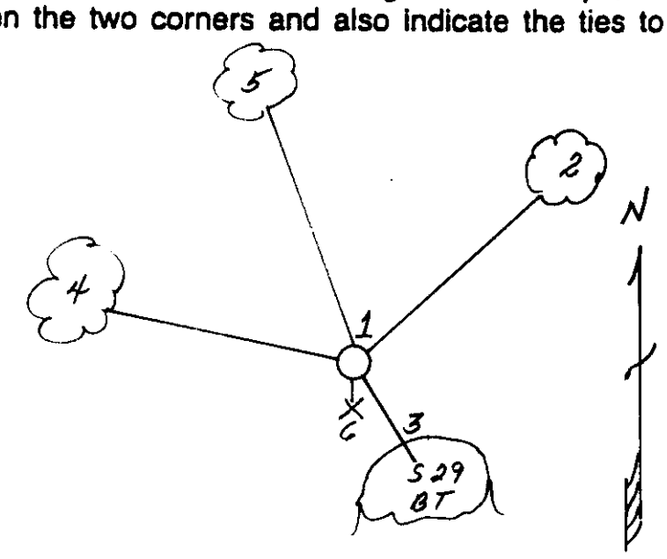

(i) I, Milo E. Stefan (type or print name) certify that the corner location on this record was determined by me or under my direction and control and that this U.S. Public Land Survey Monument Record is correct and complete to the best of my knowledge and belief.

Milo E. Stefan

Signature — Date

WISCONSIN MILO E. STEFAN S-1648 OCONTO, WIS. LAND SURVEYOR

Index No. R-5

3509190000