


# U.S. PUBLIC LAND SURVEY MONUMENT RECORD

Note: This form is intended and designed to fulfill all requirements of Wisconsin Administrative Code, Chapter A-E 7.08 U.S. Public Land Survey Monument Record (3) (a) (b) (c) (d) (e) (f) (g) (h) (i). An additional sheet may be added if necessary to conform with said requirements.

(a) Corner location: Township 35 North  
 Range 9 East/West

Town/City/Village Enterprise

County Oneida

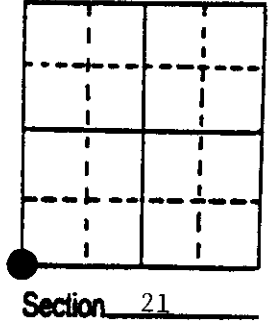

(b) (f) (g) (h) Description of monument found at this corner and if it was accepted, state all evidence (material, testimonial, occupational, plats, records, other monuments) used as a basis for accepting. If not accepted or if nothing was found, state evidence used as basis for establishing location. If reestablished through lost corner proportionate methods, indicate all monuments, distances and directions used to establish. Indicate type of monument found or set and sign post.

1864 - James Nowlin established this corner and set a wood post with two BTs and two witness trees:

22" Lynn, N8°E, 55 Links	15" Sugar, S35°W, 32 Links
26" Sugar	16" Sugar


1932/33 - Hall found Vaughn's Hemlock and charred stump of original southwest BT. He restored corner by placing a 6" x 6" x 36" concrete monument with brass cap and making one new BT: 20" White Pine, S3°E, 86.8 Links  
 Vaughn's Hemlock, N31°E, 22 1/2 Links

11/28/1989 - Milo E. Stefan found Hall's monument in excellent condition. The pine BT cut off and only stump remains. We made four new BTs and set plastic sign post.

(c) (d) (e) Plan view of corner with ties to at least 4 witness monuments. If in disagreement with previously established corner, show the distances between the two corners and also indicate the ties to the disputed corner.

- 1) 6" x 6" x 36" concrete monument/brass cap
- 2) 6" Sugar Maple, N67°E, 28.56'
- 3) 5" Sugar Maple, S55°E, 22.64'
- 4) 6" Sugar Maple, S62°W, 26.50'
- 5) 7" Sugar Maple, N20°W, 21.92'
- 6) 20" Pine Stump, S3°E, 57.3'
- 7) Location poster post, south, 129'
- 8) Plastic sign post, south, .7'


Distances to nail in side of BTs  
 Stump blazes scribed "BT"

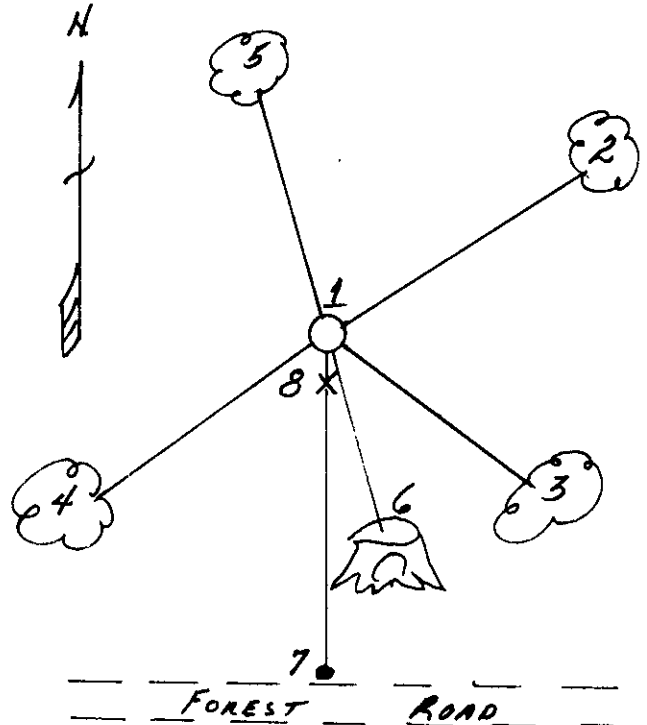

(i) I, Milo E. Stefan  
 (type or print name) certify that the corner location on this record was determined by me or under my direction and control and that this U.S. Public Land Survey Monument Record is correct and complete to the best of my knowledge and belief.

Milo E. Stefan  
 Signature

11/30/89  
 Date

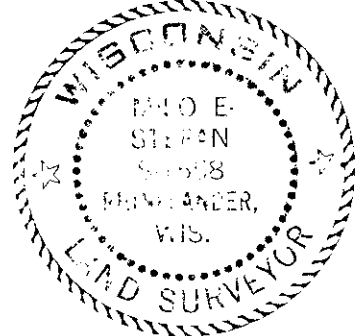

Index No. R-9