

# U.S. PUBLIC LAND SURVEY MONUMENT RECORD


Note: This form is intended and designed to fulfill all requirements of Wisconsin Administrative Code, Chapter A-E 7.08 U.S. Public Land Survey Monument Record (3) (a) (b) (c) (d) (e) (f) (g) (h) (i). An additional sheet may be added if necessary to conform with said requirements.

(a) Corner location: Township 35 North

Range 9 East/West

Town/City/Village Enterprise

County Oneida

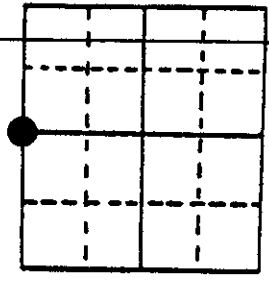

Section 24

(b) (f) (g) (h) Description of monument found at this corner and if it was accepted, state all evidence (material, testimonial, occupational, plats, records, other monuments) used as a basis for accepting. If not accepted or if nothing was found, state evidence used as basis for establishing location. If reestablished through lost corner proportionate methods, indicate all monuments, distances and directions used to establish. Indicate type of monument found or set and sign post.

1864 - James Nowlin established this corner and set a wood post with two BTs:  
 10" Tamarack, N78°E, 18 Links      7" Tamarack, S38°W, 12 Links


11/3/1969 - Jean Resvick found original Tamarack BT, fallen and restored corner by placing a 2 1/2" x 60" iron pipe with brass cap and two new BTs:  
 7" Black Spruce, N13°W, 1.9'      7" Black Spruce, N61°W, 31.24'

11/16/1989 - Milo E. Stefan found Resvick's monument tipped out from his BT that had recently blown down. We reset the monument, made three new BTs and set plastic sign post.

(c) (d) (e) Plan view of corner with ties to at least 4 witness monuments. If in disagreement with previously established corner, show the distances between the two corners and also indicate the ties to the disputed corner.

- 1) 2 1/2" x 60" iron pipe/brass cap
- 2) 5" Cedar, N4°E, 24.11'
- 3) 8" Black Spruce, N46°E, 11.82'
- 4) 2" Black Spruce, S79°W, 10.22'
- 5) 8" Black Spruce, N61°W, 31.24'
- 6) Plastic sign post on east side of monument

Distances to nail in side of BTs.

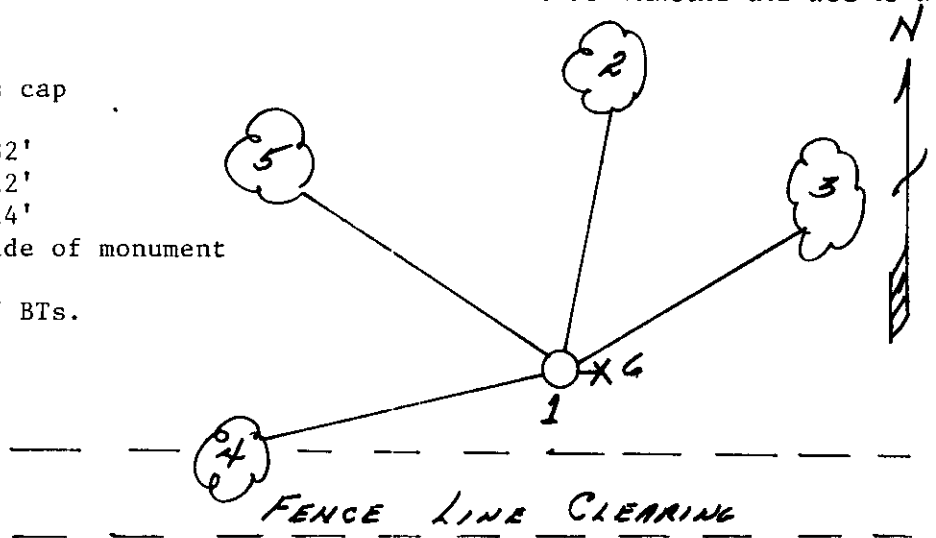

(i) I, Milo E. Stefan  
 (type or print name) certify that the corner location on this record was determined by me or under my direction and control and that this U.S. Public Land Survey Monument Record is correct and complete to the best of my knowledge and belief.



Milo E. Stefan      11/26/89  
 Signature      Date

Index No. P-21