

CERTIFIED LAND CORNER RESTORATION

Index No. R-1

State of Wisconsin


County of Oneida } ss.

I, Phillip T. Hansen, do hereby certify that on the 20th day of October, 1978, I found evidence of the Section corner of Sec. 19, 30, 25, 24 Township 35, North, Range 9 & 10 East, Fourth Principal Meridian, as described hereon; and that from this evidence I established a new monument and accessories as described hereon to perpetuate the original location of this corner.

Resident witnesses:


Jim Clafflin

Herb Wagoner

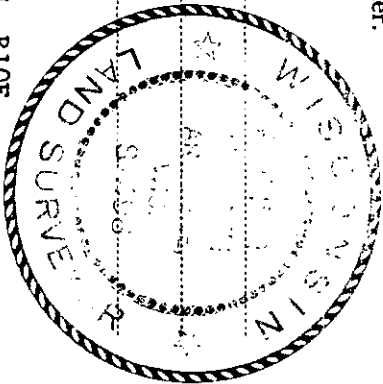

T35N R10E

S 19

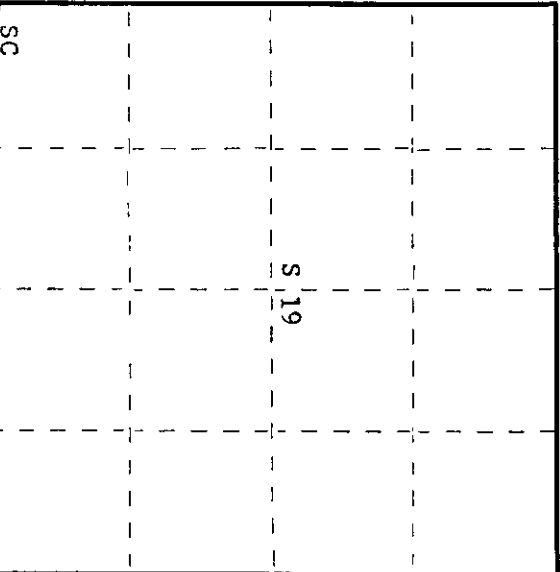

○ = Corner monument restored.

History of original corner establishment:

Original corner established by Hiram C. Fellows, Deputy Surveyor, in 1859, from which Tamarack 5" bears S 80° W, 9 links; Tamarack 8" bears N 30° W, 20 links; Spruce 10" bears N 60° E, 30 links; Tamarack 8" bears S 55° E, 25 links.

Drivas, Ripco surveyor, remonumented corner in 1961. Set new pipe and marked NBT's - Tamarack 6" S50°W 16 1/2 links
Tamarack 4" S36°E 25 links

Description of corner evidence found:

Recovered Ripco's 2 1/2" iron pipe with 3" alloy cap and Kaine's 2 1/2" iron pipe with screw-on brass cap beside it.

Recovered OBT's - Tamarack 5" (7") S50°W (S53°W), 16.5 links, scribed S25 BT.

Tamarack 5" S35°E (S32°E) 25.0 links, scribed S30 BT.

Monument projects 8" above ground. Cap stamped:

T35N R9E T35N R10E
S24 | S19
S25 | S30
RIPCO

Description of monument and accessories I established to perpetuate the original location of this corner.

Left Ripco's monument in place as recovered.

Marked NBT's - Tamarack 6" N20°E 36.4 links

Tamarack 5" N54°W 32.0 links

both scribed SC BT

Placed a 3" squared post beside it for easier location.

Dated at Rhinelander, Wis., this 27th day of November, 1978.

Signature: Philip T. Hansen Title Registered Land Surveyor Registration No. S-498
(County Surveyor, Registered Land Surveyor, or other duly authorized official)

Office of Register of Deeds, County of Oneida, I hereby certify that the within instrument was filed in this office for record on the 4th day of December, 1978 at 1:35 o'clock P. M.

Louise Verage Kuehn
(Register of Deeds)

By: _____ Deputy

350924000