U.S. PUBLIC LAND SURVEY MONUMENT RECORD

Note: This form is intended and designed to fulfill all requirements of Wisconsin Administrative Code, Chapter A-E 7.08 U.S. Public Land Survey Monument Record (3) (a) (b) (c) (d) (e) (f) (g) (h) (i). An additional sheet may be added if necessary to conform with said requirements.

(a) Corner location: Township 35 North

Range 9 East/West

Town/City/Village Enterprise

County Oneida

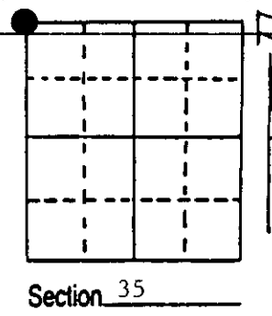

Section 35

(b) (f) (g) (h) Description of monument found at this corner and if it was accepted, state all evidence (material, testimonial, occupational, plats, records, other monuments) used as a basis for accepting. If not accepted or if nothing was found, state evidence used as basis for establishing location. If reestablished through lost corner proportionate methods, indicate all monuments, distances and directions used to establish. Indicate type of monument found or set and sign post.

1864 - James Nowlin established this corner and set a wood post with two BTs and two witness trees:

8" Birch, N36°W, 10 Lks — 8" Birch, S84½°E, 10 Lks

5" Birch, ? , ? — 6" Hemlock, ? , ?

8/5/1930 - Maine declared corner as lost and restored corner by double proportionate measure. He set an iron pipe with brass cap and two BTs:

14" Red Maple, S56°E, 126 Lks — 34" White Pine Stump, N5°E, 89½ Lks

12/12/1989 - Milo E. Stefan found Maines BTs. Monument has been removed. Found remains of concrete monument in slash piles and bulldozer heaps. Could not restore corner this day because of frozen ground.

11/23/1990 - Milo E. Stefan restored corner from Maines BTs by placement of a 2" x 36" aluminum monument, made new BTs and set plastic sign post.

(c) (d) (e) Plan view of corner with ties to at least 4 witness monuments. If in disagreement with previously established corner, show the distances between the two corners and also indicate the ties to the disputed corner.

1) 2" x 36" aluminum county monument
2) 14" Red Oak, N17°E, 80.45 feet
3) 8" Tamarack, S75°E, 64.68 feet
4) 18" Red Maple, S56°E, 83.16 feet
5) 10" Red Oak, N6°W, 59.83 feet
6) 34" White Pine Stump, N5°E, 59.07 feet
7) Plastic sign post, SE, .3 feet

Distances to nail in side of BTs.
Stump blaze scribed "BT".

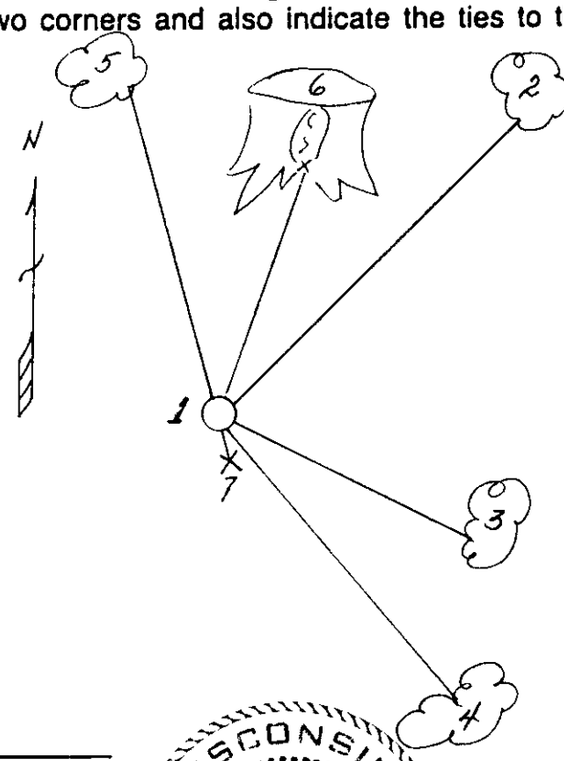

REGISTER OF DEEDS OFFICE
ONEIDA COUNTY, WIS
FILED
DEC 12 1990
At ____ O'Clock ____ M
THOMAS H. LEIGHTON
REGISTER OF DEEDS

(i) I, Milo E. Stefan (type or print name) certify that the corner location on this record was determined by me or under my direction and control and that this U.S. Public Land Survey Monument Record is correct and complete to the best of my knowledge and belief.

Milo E. Stefan — 12/5/90

Signature — Date

WISCONSIN MILO E. STEFAN S-1678 RHINELANDER, WIS. LAND SURVEYOR

Stamp

Index No. A-17

35 09 12 7 00