U.S. PUBLIC LAND SURVEY MONUMENT RECORD

Note: This form is intended and designed to fulfill all requirements of Wisconsin Administrative Code, Chapter A-E 7.08 U.S. Public Land Survey Monument Record (3) (a) (b) (c) (d) (e) (f) (g) (h) (i). An additional sheet may be added if necessary to conform with said requirements.

(a) Corner location: Township 35 North

Range 9 East/~~West~~

Town/~~City/Village~~ Enterprise

County Oneida

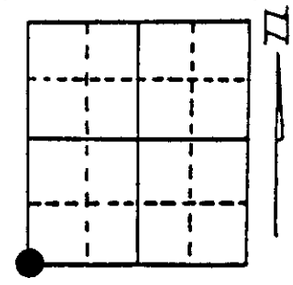

Section 28

(b) (f) (g) (h) Description of monument found at this corner and if it was accepted, state all evidence (material, testimonial, occupational, plats, records, other monuments) used as a basis for accepting. If not accepted or if nothing was found, state evidence used as basis for establishing location. If reestablished through lost corner proportionate methods, indicate all monuments, distances and directions used to establish. Indicate type of monument found or set and sign post.

1864 - James Nowlin established this corner and set a wood post with two BTs and two Witness Trees:
12" Sugar Maple, N47°E, 12 Links 10" Lynn
15" Sugar Maple, S47°W, 25 Links 16" Sugar

7/15/1936 - Maine found remains of three original BTs and set a 2 1/4" x 60" iron pipe/brass cap and made three new BTs:
12" Sugar Maple, S84 1/2°W, 59 Links 12" Hemlock, N6°E, 63 1/2 Links
24" Sugar Maple, S14 1/4°E, 33 1/2 Links

12/15/1989 - Milo E. Stefan found Maine's monument and Hemlock BT in good condition, other BTs gone. We made three new BTs and set plastic sign post.

(c) (d) (e) Plan view of corner with ties to at least 4 witness monuments. If in disagreement with previously established corner, show the distances between the two corners and also indicate the ties to the disputed corner.

1) 2 1/4" x 60" iron pipe/brass cap
2) 14" Hemlock, N6°E, 42.10' (Maines)
3) 6" Red Oak, S14°E, 3.92'
4) 14" Sugar Maple, S34°W, 20.18'
5) 5" Red Oak, N56°W, 24.85'
6) Plastic sign post, northwest, 1.1'

Distances to nail in side of BTs.
Stump blazes scribed "BT".

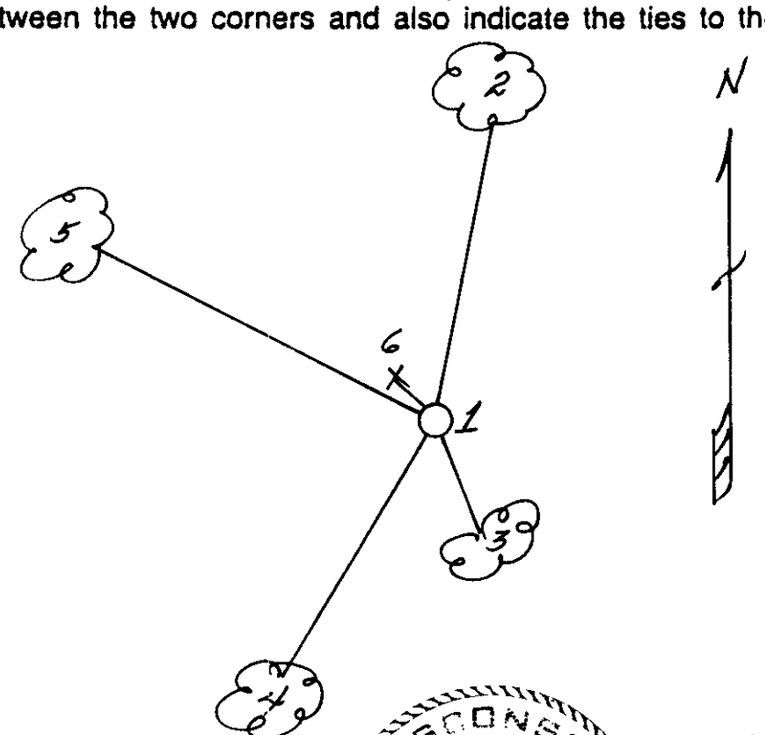

(i) I, Milo E. Stefan **(type or print name) certify that the corner location on this record was determined by me or under my direction and control and that this U.S. Public Land Survey Monument Record is correct and complete to the best of my knowledge and belief.**

Milo E. Stefan 12/16/89

Signature Date

WISCONSIN MILO E. STEFAN S-1558 RHINELANDER, WIS. LAND SURVEYOR

Stamp

Index No. V-9

35C9290000