


U.S. PUBLIC LAND SURVEY MONUMENT RECORD

Note: This form is intended and designed to fulfill all requirements of Wisconsin Administrative Code, Chapter A-E 7.08 U.S. Public Land Survey Monument Record (3) (a) (b) (c) (d) (e) (f) (g) (h) (i). An additional sheet may be added if necessary to conform with said requirements.

(a) Corner location: Township 35 North
 Range 9 East/West

Town/City/Village Enterprise
 County Oneida

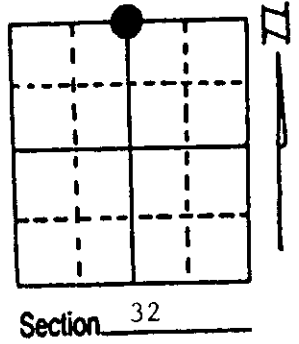

(b) (f) (g) (h) Description of monument found at this corner and if it was accepted, state all evidence (material, testimonial, occupational, plats, records, other monuments) used as a basis for accepting. If not accepted or if nothing was found, state evidence used as basis for establishing location. If reestablished through lost corner proportionate methods, indicate all monuments, distances and directions used to establish. Indicate type of monument found or set and sign post.



October 1864 - James Nowlin established this corner at 40.25 chains, set a wood post and two BTs:
 10" W. Birch, S65°W, 12 Links (7.92')
 10" W. Birch, S62°W, 25 Links (16.5')

5/9/1995 - Milo E. Stefan found a 2" x 60" iron pipe with brass cap. This in the vintage of Maine's work to the West. No records of when or who placed this corner.
 I accept it as a perpetuated corner position and restored the same.
 We made four new BTs and set a plastic sign post.

(c) (d) (e) Plan view of corner with ties to at least 4 witness monuments. If in disagreement with previously established corner, show the distances between the two corners and also indicate the ties to the disputed corner.

- 1) 2" x 60" Iron Pipe/Brass Cap.
- 2) 8" Sugar Maple, N28°E, 42.08'
- 3) 13" Sugar Maple, S27°E, 22.09'
- 4) 4" Red Pine, S48°W, 33.05'
- 5) 8" Red Maple, N4°W, 17.13'
- 6) Plastic Sign Post, West, 1.0'

Distances to nail in side of BTs.
 Stump blaze scribed "BT".
 BT tags placed on face of each BT.

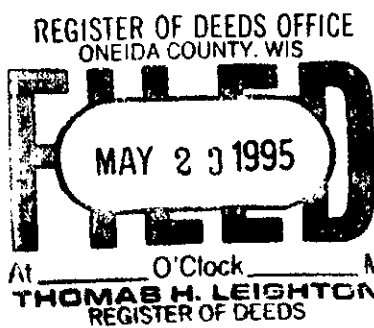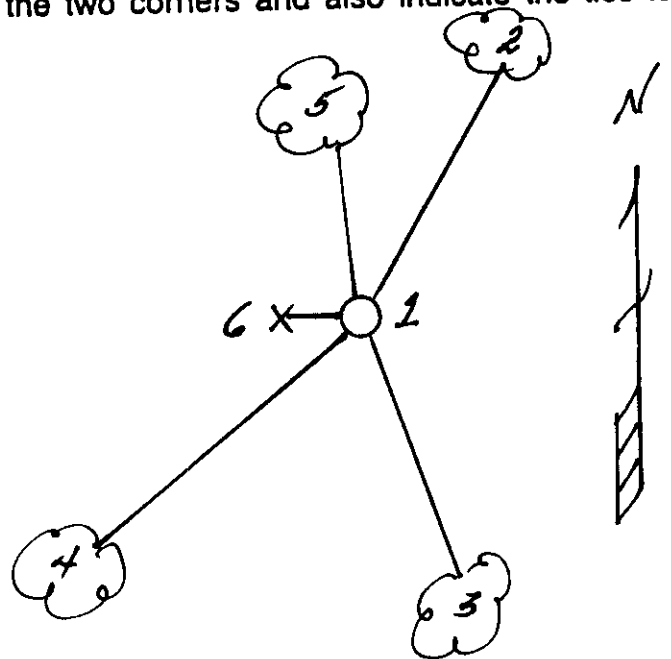

(i) I, Milo E. Stefan
 (type or print name) certify that the corner location on this record was determined by me or under my direction and control and that this U.S. Public Land Survey Monument Record is correct and complete to the best of my knowledge and belief.

Milo E. Stefan Signature May 11, 1995 Date



Index No. V-7