


U.S. PUBLIC LAND SURVEY MONUMENT RECORD

Note: This form is intended and designed to fulfill all requirements of Wisconsin Administrative Code, Chapter A-E 7.08 U.S. Public Land Survey Monument Record (3) (a) (b) (c) (d) (e) (f) (g) (h) (i). An additional sheet may be added if necessary to conform with said requirements.

(a) Corner location: Township 35 North
 Range 9 East/West

Town/City/Village Enterprise
 County Oneida

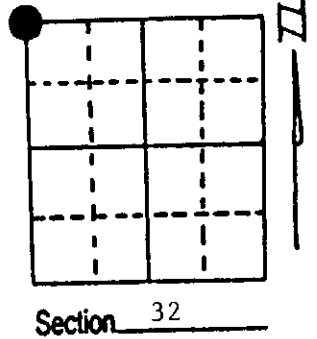

(b) (f) (g) (h) Description of monument found at this corner and if it was accepted, state all evidence (material, testimonial, occupational, plats, records, other monuments) used as a basis for accepting. If not accepted or if nothing was found, state evidence used as basis for establishing location. If reestablished through lost corner proportionate methods, indicate all monuments, distances and directions used to establish. Indicate type of monument found or set and sign post.


October 1864 - James Nowlin established this corner at 80.00 chains, set a wood post/four BTs:
 6" Birch, N71°E, 18 Links (11.88') ?" Birch, S80°W, 25 Links (16.5')
 12" Birch, No Bearing or Distance 10" White Pine, No Bearing or Distance
 Given. Given.

8/22/1925 - Vern Maine found old wood stake, and witnessed by Peter Stefanick, a long time resident. Stake was under gate. Maine used this corner to restore Quarter Corner to the West and established the East 1/16 to the West.

5/1995 - Milo E. Stefan restored this corner by measurement from Maine's Quarter Corner to the West - 2257.2 feet and on line between the Quarter Corners East and West one-half mile. Position falls on South edge of Stefanecz Road.
 We buried a 2" x 30" aluminum monument 6" below surface, made four new BTs and set plastic sign post.

(c) (d) (e) Plan view of corner with ties to at least 4 witness monuments. If in disagreement with previously established corner, show the distances between the two corners and also indicate the ties to the disputed corner.

- 1) 2" x 30" aluminum monument.
- 2) 18" Red Oak, N62°E, 74.46'.
- 3) 12" Red Oak, S37°E, 36.20'.
- 4) 14" Red Oak, South, 46.80'.
- 5) 12" Red Oak, S35°W, 39.88'.
- 6) Plastic Sign Post, South, 5.0'.

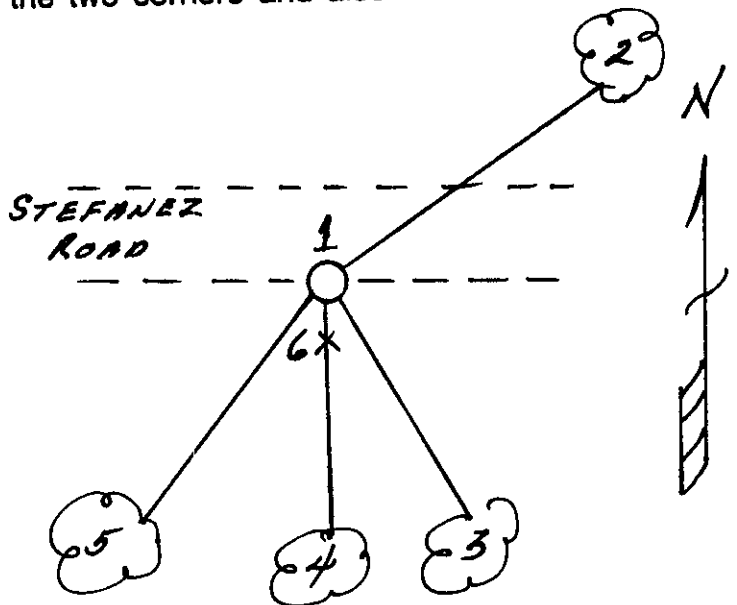

Distances to nail in side of BTs.
 Stump blaze scribed "BT".
 BT tags placed on face of each BT.

REGISTER OF DEEDS OFFICE
 ONEIDA COUNTY, WIS.
FILED
 MAY 23 1995
 At _____ O'Clock _____ M
 THOMAS H. LEIGHTON
 REGISTER OF DEEDS

(i) I, Milo E. Stefan
 (type or print name) certify that the corner location on this record was determined by me or under my direction and control and that this U.S. Public Land Survey Monument Record is correct and complete to the best of my knowledge and belief.

Milo E. Stefan Signature May 11, 1995 Date



Index No. V-5