


U.S. PUBLIC LAND SURVEY MONUMENT RECORD

Note: This form is intended and designed to fulfill all requirements of Wisconsin Administrative Code, Chapter A-E 7.08 U.S. Public Land Survey Monument Record (3) (a) (b) (c) (d) (e) (f) (g) (h) (i). An additional sheet may be added if necessary to conform with said requirements.

(a) Corner location: Township 35 North
 Range 9 East/West

Town/City/Village Enterprise

County Oneida

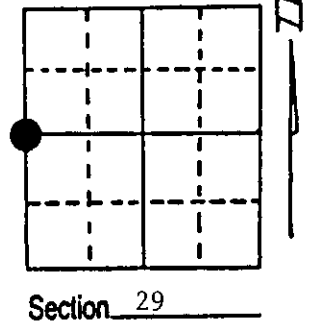

(b) (f) (g) (h) Description of monument found at this corner and if it was accepted, state all evidence (material, testimonial, occupational, plats, records, other monuments) used as a basis for accepting. If not accepted or if nothing was found, state evidence used as basis for establishing location. If reestablished through lost corner proportionate methods, indicate all monuments, distances and directions used to establish. Indicate type of monument found or set and sign post.

10/1864 - James Nowlin set post for Quarter Corner at 40.00 chains and made two BTs:
 15" Sugar, S47°E, 23 Links (15.18') 15" Sugar, N48°W, 18 Links (11.88')


11/27/1935 - A.J. Lytle found stumps of original BTs. Made a new tie:
 24" White Pine Stump, N9°W, 35 Links (23.10')

8/25/1994 - Milo E. Stefan found 2" x 60" iron pipe/brass cap (not stamped) marking corner. Lytle Pine BT nearly rotted away. Good stump hole to SE original BT. NW original not concernable.

(c) (d) (e) Plan view of corner with ties to at least 4 witness monuments. If in disagreement with previously established corner, show the distances between the two corners and also indicate the ties to the disputed corner.

- 1) 2" x 60" Iron Pipe/Brass Cap.
- 2) 12" Red Oak, N40°E, 19.70'.
- 3) 6" Sugar Maple, S42°E, 34.03'.
- 4) 10" Red Oak, N60°W, 34.27'.
- 5) 6" Sugar Maple, N18°W, 48.00'.
- 6) Plastic Sign Post, NW, 1.1'.

Distance to nail in side of BT.
 Stump blaze scribed "BT".

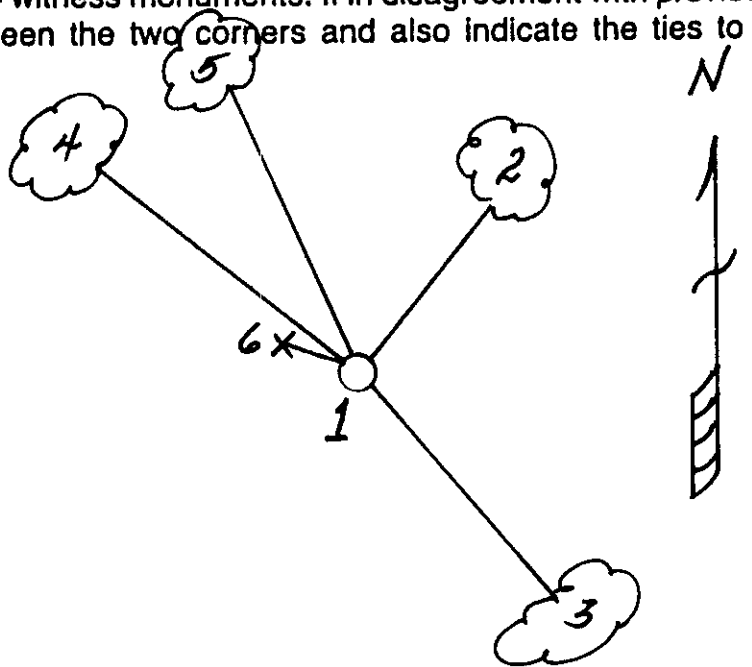

(i) I, Milo E. Stefan
 (type or print name) certify that the corner location on this record was determined by me or under my direction and control and that this U.S. Public Land Survey Monument Record is correct and complete to the best of my knowledge and belief.

Milo E Stefan 10/9/94
 Signature Date



Index No. T-5

3509302000

Stamp