

CERTIFIED LAND CORNER RESTORATION

History of original corner establishment:

COPY FROM
HANGLOADE ETC.
Index No. ~~4-21~~
2-21
3509

State of Wisconsin } ss.



County of _____

I, _____, do hereby certify that on the _____ day of _____, 19____, I found evidence of the _____ corner of _____ Township _____ North, Range _____, Fourth Principal Meridian, as described hereon; and that from this evidence I established a new monument and accessories as described hereon to perpetuate the original location of this corner.

Resident witnesses:

Description of monument and accessories I established to perpetuate the original location of this corner.

1 1/2" red line 48" 5'6"
4" red line 22" 2'5"
1/2" black 22" 2'0"

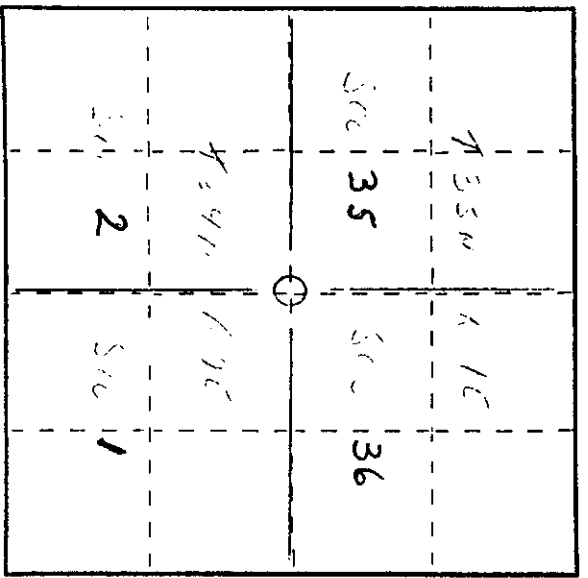 

○ = Corner monument restored.

Dated at _____ Wis., this _____ day of _____, 19____.

Signature _____ Title _____ Registration No. _____
(County Surveyor, Registered Land Surveyor, or other duly authorized official)

Office of Registrar of Deeds, County of _____, I hereby certify that the within instrument was filed in this office for record on the _____ day of _____, 19____ at _____ o'clock _____ M.

(Registrar of Deeds)

By _____ Deputy

3501350000