

CERTIFIED LAND CORNER RESTORATION

Index No. **E-24**

State of Wisconsin

County of Oneida } ss.



I, Phillip T. Hansen, do hereby certify that on the 29th day of April, 1976, I found evidence of the 1/16 corner of Section 1 and 12 Township 35, North, Range 10 East, Fourth Principal Meridian, as described hereon; and that from this evidence I established a new monument and accessories as described hereon to perpetuate the original location of this corner.

Resident witnesses:

Glen Barker

Jim Clafflin

Herb Wagoner

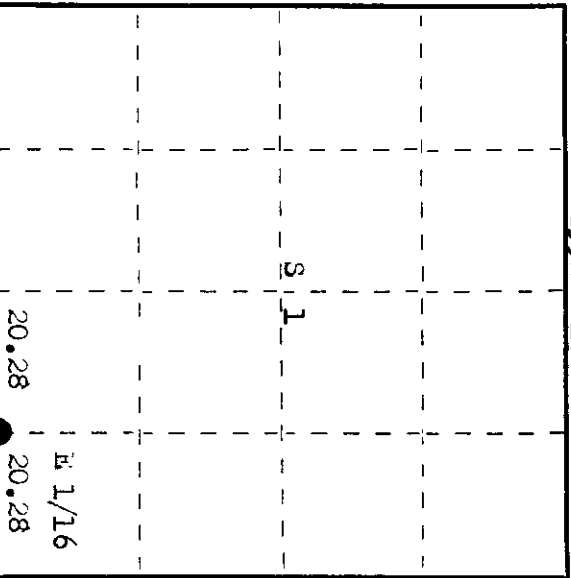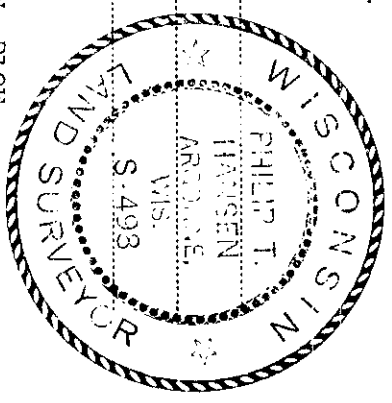

○ = Corner monument restored.

History of original corner establishment: Corner established by H.C. Lawrence, registered land surveyor, in 1954. From recovered SW corner, section 1, he ran a random line N 88° W along an old fence line 40.25 chains and searched for 1/4 corner between sec. 1 and 12. As this had been all cut over on several occasions, no evidence of corner was found. Continued N 88° W and at 81.12 chains intersected line between 1 and 2, 28 lks north of section corner. Established 1/4 corner at 40.56 chains, 14 lks south. Set W 1/16 corner at 20.28 chains, 7 lks south. Marked corner with 4" hemlock post and marked NBTs. Hemlock 8" N 20° E 14 lks and Y. Birch 5" S 75° W 24 lks.

Description of corner evidence found:

Recovered 4" hemlock post, squared and scribed E 1/16 S1, E 1/16 S12 in fair condition.

Recovered NBTs - Hemlock 8" N 20° E (N 30° E) 14 lks, scribed E 1/16 BT.

Y. Birch 5" (6") S 75° W (S 85° W) 24 lks (23.6 lks), scribed S12 BT.

Description of monument and accessories I established to perpetuate the original location of this corner. Replaced hemlock post with 1 1/2" iron pipe with 2" brass cap stamped.

Pipe projects 18" above ground.

NBT - Maple 9" N 55° W 45.4 lks, scribed 1/16 BT.

S498
T35N R10E

E 1/16 S 1/12

CHI-1976

Dated at Rhineland, Wis., this 16th day of July, 1976.

Signature Phillip T. Hansen Title Registered Land Surveyor Registration No. S-498
(County Surveyor, Registered Land Surveyor, or other duly authorized official)

Office of Register of Deeds, County of Oneida, I hereby certify that the within instrument was filed in this office for record on the 23rd day of July, 1976 at 10 o'clock P. M.

Debra S. Berger
(Register of Deeds)

By _____ Deputy

2510010010