


CERTIFIED LAND CORNER RESTORATION

Index No. **E-23**

State of Wisconsin }
 County of Oneida } ss.

I Philip T. Hansen, do hereby certify that on the 29th day of April, 1976, I found evidence of the quarter corner of Section 1 and 12 Township 35 North, Range 10 East, Fourth Principal Meridian, as described hereon; and that from this evidence I established a new monument and accessories as described hereon to perpetuate the original location of this corner.

Resident witnesses:
 Glen Barker
 Jim Claffin
 Herb Wagoner

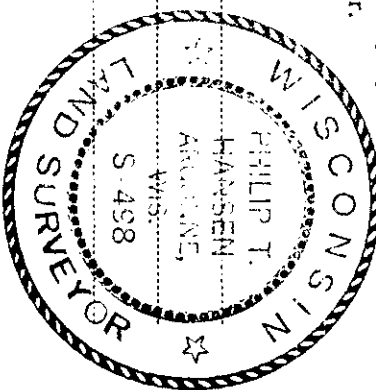


History of original corner establishment: Original Corner established by James L. Nowlin in 1865, from which Sugar 10" bears N 32° W 7 lks, Maple 12" bears S 5° E 15 lks. Corner reestablished by H.C. Lawrence, Registered Land Surveyor, in 1954. From SW Corner Sec. 1 he ran a random line N 88° W along an old fence line 40.25 chains; original distance and searched for evidence of old corner, but not recovered. Continued N 88° W and at 81.12 chains, intersected the line between Sec 1 and 2, 28 lks North of Section Corner. Set new post for 1/4 corner, at 40.56 chains, 14 lks south. Marked WBTS - Wash 9" N 70° W 24 lks and Sugar 9" S 35° E 14 lks.

Description of corner evidence found: Recovered 4" cedar post, squared and scribed 1/4 S1, 1/4 S12 in fair condition. A rock cairn had been placed around base of post.

Recovered OBT - Wash 9" (10") N 70° W 24 lks, scribed 1/4 S1 BT.
 Sugar 9" S 35° E (S 32° E) 14 lks, scribed 1/4 S12 BT.

Description of monument and accessories I established to perpetuate the original location of this corner.
 Replaced 4" cedar post with 2 1/2" x 1 Vertusen monument, stamped.
 Monument projects 2 1/2" above ground.
 NBT - Sugar 8" N 15° E 62 lks, scribed 1/4 BT.
 Replaced rock cairn around base of monument.
 Monument and BTs painted blue.

T35N R10E
 S11
 S12
 S498 1976

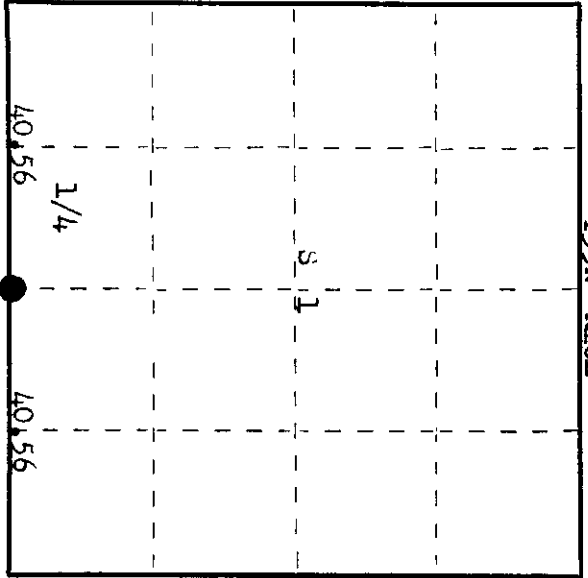

○ = Corner monument restored.

Dated at Rhineland, Wis., this 16th day of July, 1976

Signature *Philip T. Hansen* Title Registered Land Surveyor Registration No. S-498
 County Surveyor, Registered Land Surveyor, or other duly authorized official

Office of Register of Deeds, County of Oneida
 Instrument was filed in this office for record on the 23rd day of July, 1976
 at 10:00 o'clock P.M.

Thomas J. Berger
 (Register of Deeds)

By: Deputy

0000010025