

CERTIFIED LAND CORNER RESTORATION



Index No. D-1

State of Wisconsin }  
 County of Oneida } ss.

History of original corner establishment:  
 No records of any previous survey.

I, Philip T. Hansen, do hereby certify that on the 24th day of April, 1979, I ~~restored~~ <sup>restored</sup> established the corner of Section 1 and 6 Township 35 North, Range 10 & 11 East, Fourth Principal Meridian, as described hereon; and that from this evidence I established a new monument and accessories as described hereon to perpetuate the original location of this corner.

Resident witnesses:  
 Glen Barker  
 Jim Clafin  
 Herb Wagoner

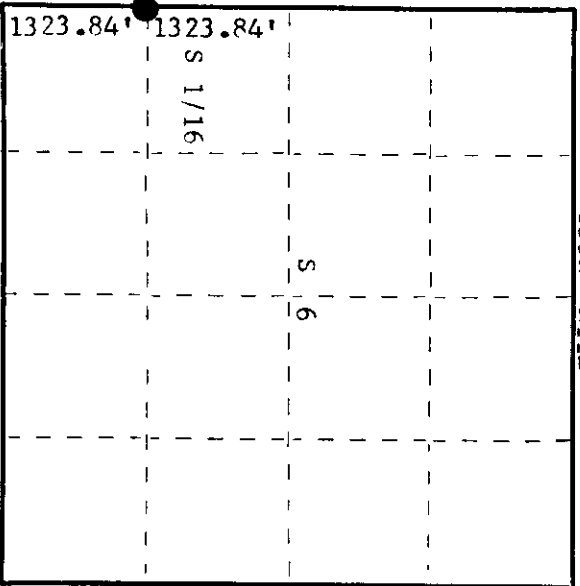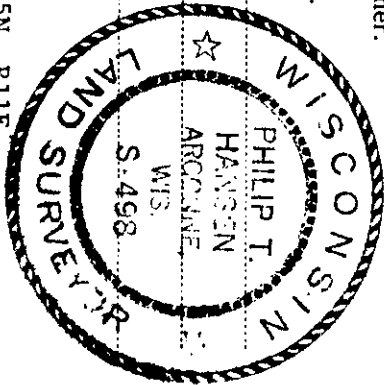

O = Corner monument restored.

Description of corner evidence found:  
 No evidence of any corner recovered.  
 Corner established by traverse and computation. Ran traverse from 1/4 corner between 1 and 6 to section corner 1, 6, 7 and 12. Total distance of 2647.677' at bearing S 1° 55' 58" E. Set S 1/16 at 1323.84' intermediate.

Description of monument and accessories I established to perpetuate the original location of this corner.  
 Drove 1 1/2" x 14" iron pipe in road bed of old highway 26 south, to point 6" below the surface for true corner.  
 Set a 1 1/2" iron pipe with 2" brass cap, 50' west for witness corner.  
 Monument projects 24" above ground. Cap stamped:  
 Marked NBT's  
 Sugar 7" S46°W 74.95' scribed 1/16 BT.  
 Sugar 6" N53°W 72.60' scribed 1/16 BT.  
 T35N  
 R10E R11E  
 S 1/16 1+6 W.C.C.  
 E - 50 ft.

Dated at Rhineland, Wis., this 24th day of April, 1979

Signature: *Philip T. Hansen* Title: Registered Land Surveyor Registration No. S-498  
 County Surveyor, Registered Land Surveyor, or other duly authorized official

Office of Register of Deeds, County of Oneida  
 Instrument was filed in this office for record on the 14th day of May, 1979 at 1:30 o'clock P.M.  
*Doris Berge Kuehn*  
 (Register of Deeds)

By: \_\_\_\_\_ Deputy

3510011000