

CERTIFIED LAND CORNER RESTORATION

Index No. **D-23**

State of Wisconsin



County of Oneida } ss.

I Phillip T. Hansen do hereby certify that on the 1st day of June, 1976, I found evidence of the SG 1/16 corner of Section 1 Township 35 North, Range 10 East, Fourth Principal Meridian, as described hereon; and that from this evidence I established a new monument and accessories as described hereon to perpetuate the original location of this corner.

Resident witnesses:

Jim Claflin

Herb Wagoner

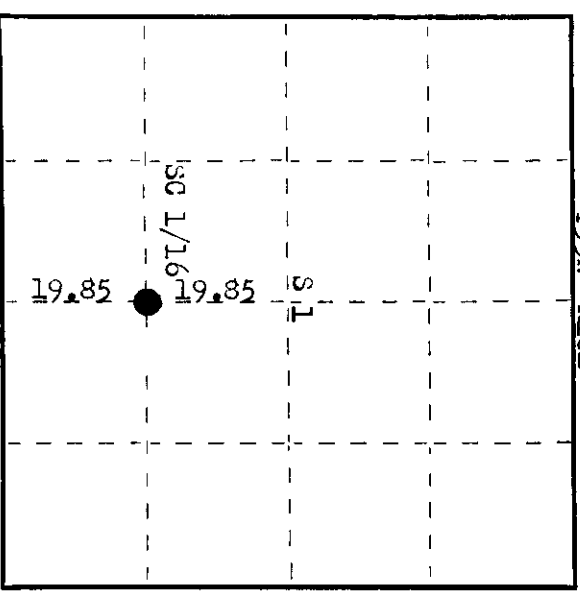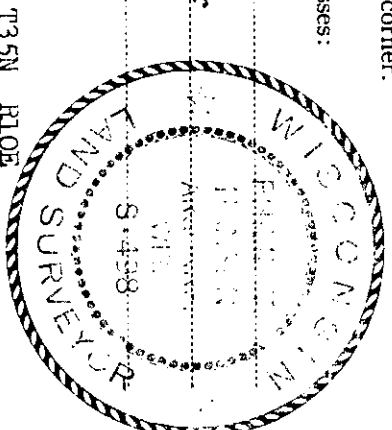

○ = Corner monument restored.

History of original corner establishment: Corner established by H.C. Lawrence, registered land surveyor, in 1949. ran random line north 2° 00' east, mag. 73.52 chains to intersect Town line 2.90 chs east of original corner. ran 1/4 line to establish 0 1/4 corner. set 0 1/4 at 19.58 chains, equidistant between S1/4 and Q1/4 corner. marked MBTs - Cedar 8" S 5° E 33 1/2 lks and B.ash 12" N 80° E 22 1/2 lks.

Description of corner evidence found:

recovered 4" squared cedar post, scribed 0 1/16 S1. 0 1/16 S1 in fair condition. recovered DBT - B.ash 12" N 80° E (N 70° E) 22.5 lks, scribed S1 BT.

This tree is now dead. Cedar 8" S 5° E 33.5 lks, scribed S1 BT. Uprooted and dead.

Description of monument and accessories I established to perpetuate the original location of this corner.

Replaced 4" cedar post with 1 1/2" iron pipe with 2" brass cap stamped.

Monument projects 20" above ground.

MBTs - Cedar 6" N 26° E 19.3 lks, scribed 1/16 BT.

Cedar 6" S 74° E 13.5 lks, scribed 1/16 BT.

Monument and BTs painted blue.

5498
T35N R10E
SG 1/16 S1
CPI-1976

3510011020

Dated at Rhinelanders Wis., this 9th day of August, 1976

Signature *Phillip T. Hansen* Title registered land surveyor Registration No. 5498
(County Surveyor, Registered Land Surveyor, or other duly authorized official)

Office of Register of Deeds, County of Oneida
Instrument was filed in this office for record on the 22nd day of September, 1976
at 10:00 o'clock M.

Jane Verage Fuchs
(Registered of Deeds)

By Deputy