

CERTIFIED LAND CORNER RESTORATION

Index No. **C1**



State of Wisconsin

County of Oneida } ss.

I, Phillip T. Hansen, do hereby certify that on the 22nd day of August, 1975, I found evidence of the Quarter corner of Sections 1 and 6 Township 35, North, Range 10 and 11 East, Fourth Principal Meridian, as described hereon; and that from this evidence I established a new monument and accessories as described hereon to perpetuate the original location of this corner.

Resident witnesses:

Glen Barker
Jim Clafin

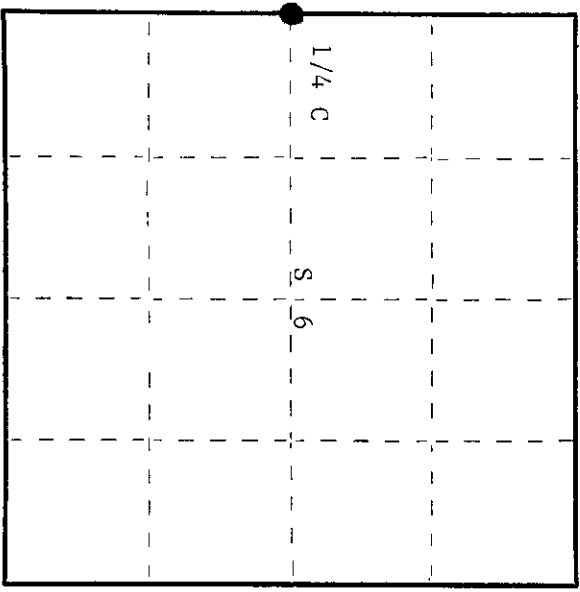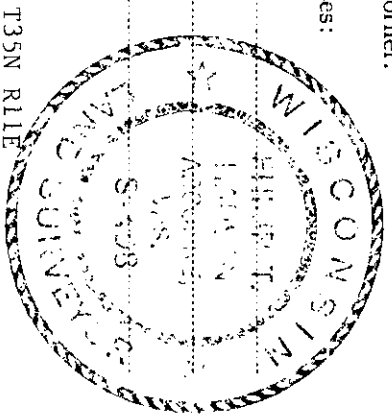

○ = Corner monument restored.

CERTIFIED LAND CORNER RESTORATION

Index No. **C1**

History of original corner establishment:
Original corner established by Hiram C. Fellows, Government Deputy Surveyor, in 1859 from which birch 10" bears N73°W, 9 links and hemlock 6" bears S31°E, 5 links. Corner re-established by H.C. Lawrence, Registered Land Surveyor, in 1949. He ran this line south from Section Corner at 36.82, found stake in center line of road with BT 16" white pine N79°W, 92-1/2 links at 37.72 chains, he intersected a point where old 1/4 line runs east in Section 6. This was south line of State 40 with virgin timber and recent cutting to south. At 77.75 intersect SW corner at fence line between Sections 1 and 12. Set 4" cedar post at 37.72, witness corner, 50 links east.

Description of corner evidence found:
Recovered 4" cedar post, squared and scribed 1/4S S1 W.C. 50 links east, 1/4S S6 in good condition.

Description of monument and accessories I established to perpetuate the original location of this corner.

Drove 1-1/2" OD x 18" iron pipe in road flush with the ground for corner. Replaced wooden witness corner with 2-1/2" iron pipe w/brass cap stamped -

The iron pipe 1-1/2" x 18" sits on the east side of the range line road.
NBT's: Cedar 9" N64°W 86 links-scribed 1/4 BT R 10 1/4 S1 S6 W.C. 11
White birch 6" S80°E 74.5 links-scribed 1/4 BT E West 50 links CPT-1975
Bearings and distances to BT's are from the true corner.

Dated at Rhinelander, Wis., this 12th day of September, 1975.

Signature Phillip T. Hansen Title Registered Land Surveyor Registration No. S-498
(County Surveyor, Registered Land Surveyor, or other duly authorized official)

Office of Register of Deeds, County of Oneida. I hereby certify that the within instrument was filed in this office for record on the 17th day of November, 1975 at 10:08 o'clock A. M.

Doris Savage Fuchs
(Register of Deeds)

By _____ Deputy

3510012000