

CERTIFIED LAND CORNER RESTORATION



Index No. C-23

State of Wisconsin }
 County of Oneida } ss.

I, Phillip T. Hansen, do hereby certify that on the 29th day of April, 1976, I found evidence of the EC 1/16 corner of Section 1 Township 35, North, Range 10 East, Fourth Principal Meridian, as described hereon; and that from this evidence I established a new monument and accessories as described hereon to perpetuate the original location of this corner.

Resident witnesses:

Glen Barker
 Jim Clafflin

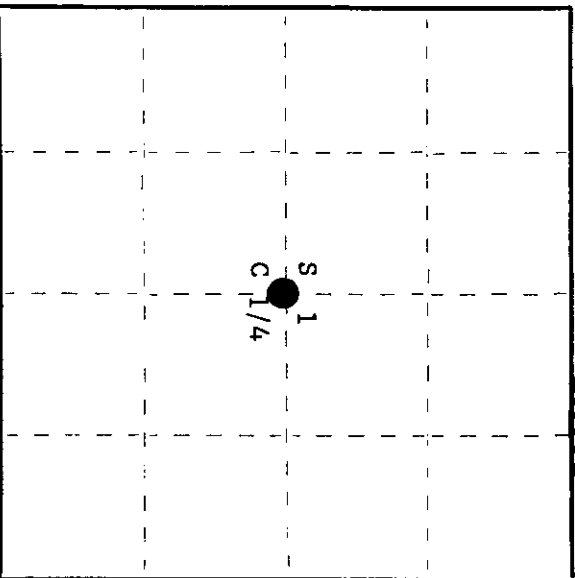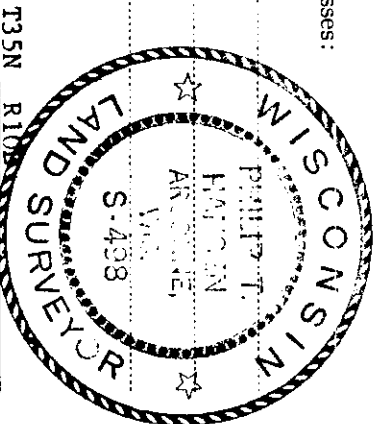

○ = Corner monument restored.

History of original corner establishment:

Corner established by H.C. Lawrence, Registered Land Surveyor, in 1949. Ran east-west 1/4 line and north-south 1/4 line from previously established 1/4 corners to establish the C 1/4 corner. Corner set at 38.95 chains east of East 1/4 corner.
 Marked NBT's - cedar 8" S10°E 21-1/2 links
 black ash 12" N75°E 23 links
 Wincentzen's C 1/4 corner bears S 25° E 99-1/2 links.

Description of corner evidence found:

Recovered 3" cedar post, squared and scribed C 1/4 S1, C 1/4 S1 in fair condition.
 Recovered Cedar 8" (10") S10°E (S4°E) 21.5 links, scribed S1 BT.
 Black Ash 12" N75°E (N77°E) 23 links, scribed C 1/4 BT.

Description of monument and accessories I established to perpetuate the original location of this corner.

Replaced cedar post with 2-1/2" Bernitsen A-1 Federal Monument, stamped:
 Placed old wood post beside it.
 Marked NBT - Cedar 14" S80°W 63.6 links, scribed 1/4 BT.

T35N R10E
 S 1
 C 1/4
 S498 - 1976

Dated at Rhineland, Wis., this 14th day of January, 1980.

Signature: Phillip T. Hansen Title: Registered Land Surveyor Registration No. S-498
 (County Surveyor, Registered Land Surveyor, or other duly authorized official)

Office of Register of Deeds, County of Oneida
 Instrument was filed in this office for record on the 11th day of February, 1980
 at 2:15 o'clock P. M.

Donna Berger Fuchs
 (Register of Deeds)

By: _____ Deputy

3510012020