

CERTIFIED LAND CORNER RESTORATION



Index No. **C-22**

State of Wisconsin }
 County of Oneida } ss.

I Phillip T. Hansen, do hereby certify that on the 24th day of May, 1976, I found evidence of the WC 1/16 corner of Section 1 Township 35, North, Range 10 East, Fourth Principal Meridian, as described hereon; and that from this evidence I established a new monument and accessories as described hereon to perpetuate the original location of this corner.

Resident witnesses:

Glen Barker
Jim Claflin
Herb Jagoner

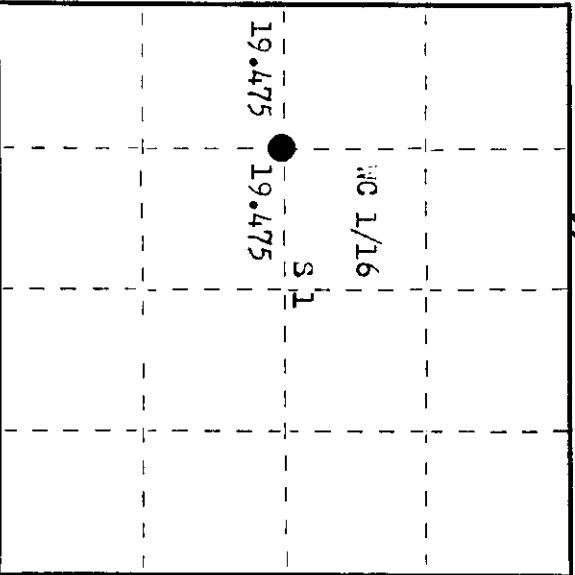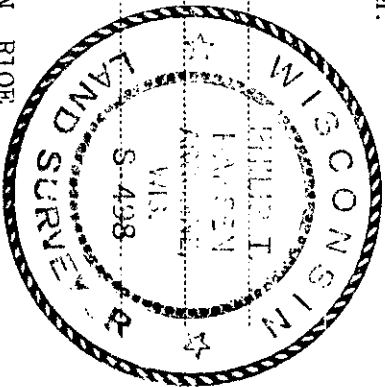

○ = Corner monument restored.

History of original corner establishment:

Corner established by H.C. Lawrence, Registered Land Surveyor, in 1949. From previously established $C 1/4$ and restored $1/4$ corner, set the $WC 1/16$ at 19.475 chains, equidistant. Set a 3" cedar post and marked NBTs - Cedar 16" $S 20^{\circ} W$ 41 lks and leaning cedar 18" $N 75^{\circ} W$ 28 lks. Wincentsen's $WC 1/16$ corner was $S 25^{\circ} E$ 99 lks from Lawrence's established corner.

Description of corner evidence found:

Recovered Lawrence's 3" cedar post, squared and scribed $WC 1/16 S 1$, $WC 1/16 S 1$, in poor condition.
 Recovered UBT - Cedar 16" $S 20^{\circ} W$ 41 lks, scribed $WC 1/16 BT$. (now dead)
 Leaning Cedar 18" $N 75^{\circ} W$ 28 lks, scribed $S 1-BT$.

Description of monument and accessories I established to perpetuate the original location of this corner.
 Replaced 3" cedar post with 1 1/2" iron pipe with 2" brass cap stamped.

Monument projects 12" above ground.
 NBT - Cedar 16" $S 44^{\circ} W$ 58.0 lks, scribed $1/16 BT$.
 Drove support stakes beside monument for support.
 Monument and BTs painted blue.

$S 498$
 T35N R10E
 $WC 1/16 S 1$
 CPI-1976

Dated at Rhineland, Wis., this 5th day of August, 1976

Signature Phillip T. Hansen Title Registered Land Surveyor Registration No. S-498
 County Surveyor, Registered Land Surveyor, or other duly authorized official

Office of Register of Deeds, County of Oneida. I hereby certify that the within instrument was filed in this office for record on the 24th day of May, 1976 at 10:00 o'clock P. M.

Debra Wayne Kuehn
 (Register of Deeds)

By _____ Deputy

3510012030