

CERTIFIED LAND CORNER RESTORATION

Index No. **B-23**



State of Wisconsin } ss.  
 County of Oneida }

I Phillip T. Hansen, do hereby certify that on the 1st day of June, 1976, I found evidence of the NC 1/16 corner of Section 1, Township 35, Range 10 East, Fourth Principal Meridian, as described hereon; and that from this evidence I established a new monument and accessories as described hereon to perpetuate the original location of this corner.

Resident witnesses:

Jim Clafflin

Herb Wagoner

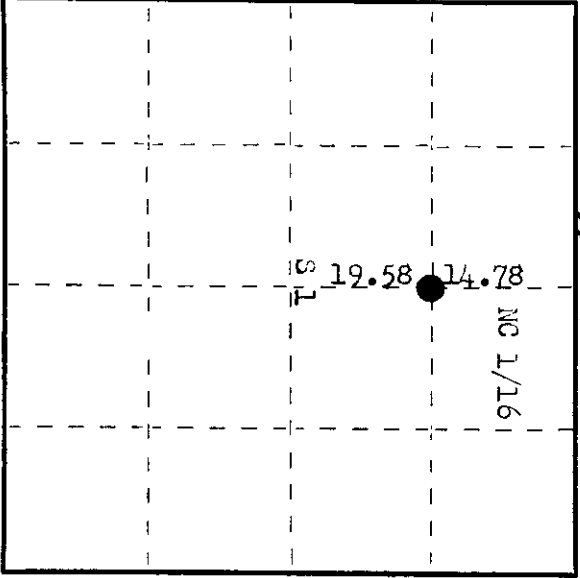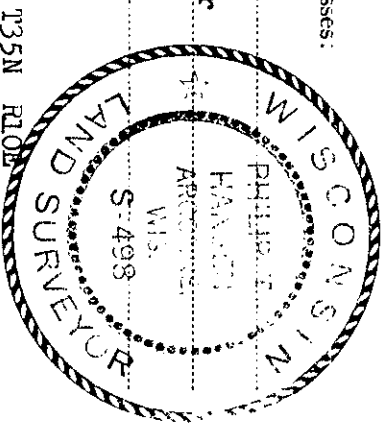

○ = Corner monument restored.

History of original corner establishment: Corner established by H.C. Lawrence, registered land surveyor, in 1949. ran random line, N-S 1/4 line N 20° 00' from recovered 1/4 corner 73.52 chains to intersect town line at 2.90 chains east of 1/4 corner. set NC 1/16 at 2.32 chains west of random line at 58.74 chains north. as this fell on rock ledge and was unable to set post, squared and scribed a 10" cedar tree on 4 sides for corner and marked maple 12" N 70° W 10 1/2 lks.

Description of corner evidence found:  
 Recovered 11" squared cedar tree, blazed and scribed on all four sides NC 1/16 S1,  
 NC 1/16 S1.  
 Recovered maple 12" N 70° W 10.5 lks, scribed 1/16 BT.

Description of monument and accessories I established to perpetuate the original location of this corner.  
 Set a 1" iron pipe with 2" brass cap along south side of tree 1 lk from center of tree. Cap stamped.  
 Monument projects 2 1/4" above ground. S498  
 MBT - Cedar 10" N 48° W 54.0 lks, scribed 1/16 BT. T35N R10E  
 A large rock outcrop (ledge) bears S 40° W approximately NC 1/16 S1  
 2 chains from corner. CPI-1976  
 Monument and BT painted blue.

Dated at Rhineland, Wis. this 9th day of August, 1976

Signature *Phillip T. Hansen* Title registered land surveyor Registration No. S-498  
 (County Surveyor, Registered Land Surveyor, or other duly authorized official)

Office of Register of Deeds, County of Oneida  
 Instrument was filed in this office for record on the 2nd day of September, 1976  
 at 10:00 o'clock M.

*Terese Teragge Furbach*  
 (Register of Deeds)

By \_\_\_\_\_ Deputy

3510013020