

CERTIFIED LAND CORNER RESTORATION

Index No. **E-19**

State of Wisconsin

County of Oneida

ss.

I, Phillip T. Hansen, do hereby certify that on the 28th day of June, 1978, I found evidence of the 1/4 corner of Sections 2 & 11

Township 35, North, Range 10 East, Fourth Principal Meridian,


as described hereon; and that from this evidence I established a new monument and accessories as described hereon to perpetuate the original location of this corner.

Resident witnesses:


Jim Claflin

Herb Wagoner

John Masbaum

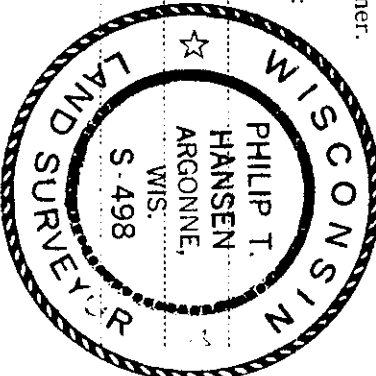

T35N R10E

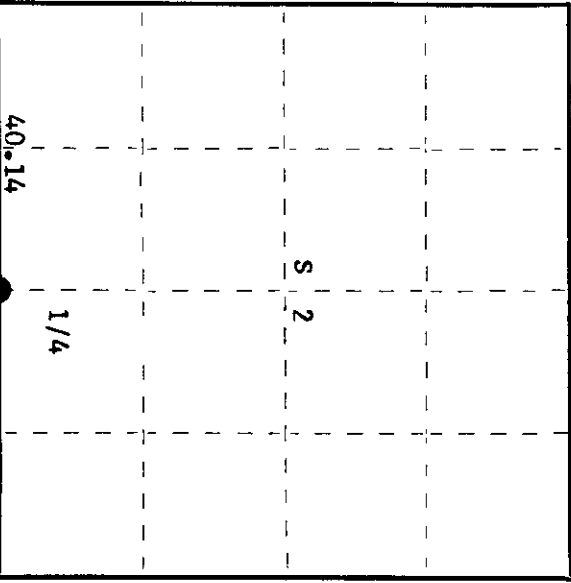

○ = Corner monument restored.

History of original corner establishment:

Original corner established by James L. Nowlin, Deputy Surveyor, in 1865, from which N. Pine 9" bears N 18° E 4 links and N. Pine 12" bears S 34° E, 25 links. H.C. Lawrence, Registered Land Surveyor, recovered original N. Pine stump N 18° E, 4 links in 1954. Set new 7" cedar post and marked NBT's - W.Pine 16" S 2° W, 29 1/2 links and N.Pine 8" N 20° E, 15 1/2 links.

Description of corner evidence found:

Recovered H.C. Lawrence's 7" square cedar post, scribed 1/4S S2 - 1/4S S11 in poor condition. Ripco's 2" iron pipe with 3" square brass cap setting beside it in good condition.

Recovered H.C. Lawrence's white pine 16" S2°W, 29.5 links, scribed 1/4 S11. red pine 14" N27°E, 16.4 links, scribing grown over. Monument projects 3' above ground. Cap stamped: T35N R10E 1/4 S 1/2 S 1/11

Description of monument and accessories I established to perpetuate the original location of this corner.

Marked NBT's - Red Pine 16" S88°W, 39.1 links, scribed 1/4 BT. Red Pine 16" S80°E, 21.3 links, scribed 1/4 BT. Distances measured to center of trees.

Dated at Rhinelander, Wis., this 10th day of July, 1978.

Signature Phillip T. Hansen, Title Registered Land Surveyor, Registration No. S-498 (County Surveyor, Registered Land Surveyor, or other duly authorized official)

Office of Register of Deeds, County of Oneida, at 10 o'clock P. M. 18th day of August, 1978

Donie Vergas Truher (Register of Deeds)

By: \_\_\_\_\_ Deputy

3510020020