

CERTIFIED LAND CORNER RESTORATION

Index No.

C-19

State of Wisconsin

County of Oneida } ss.

I Philip T. Hansen, do hereby certify that on the 14th day of November, 1975, I found evidence of the C-1/4 corner of Section 2



Township 35 North, Range 10 East, Fourth Principal Meridian,

as described hereon; and that from this evidence I established a new monument and accessories as described hereon to perpetuate the original location of this corner.

Resident witnesses:

Glen Barker

Jim Claflin

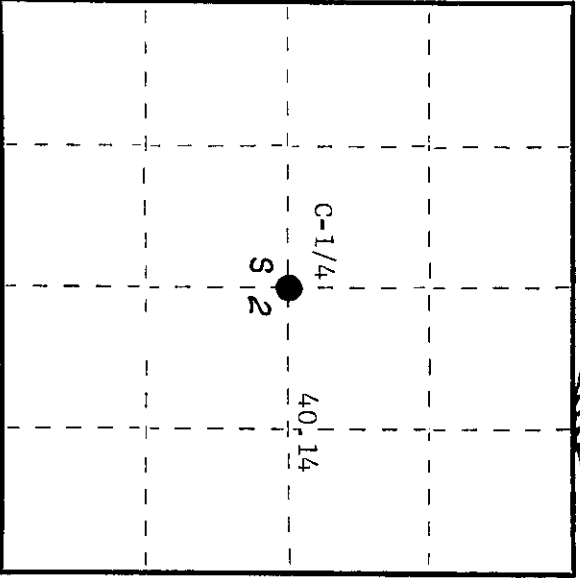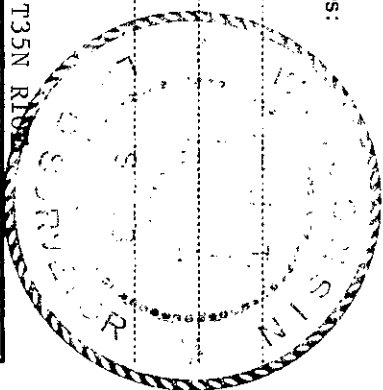

○ = Corner monument restored.

History of original corner establishment:

Corner originally established by B.F. Dorr, County Surveyor, in 1896, from which cedar 12" bears N8°E, 13-1/2 links and white pine 12" bears S19°E, 25-1/2 links. Corner recovered by H.C. Lawrence, Registered Land Surveyor, in 1954. Set a 6" cedar post from Dorr's BT's which he found well marked and legible. Marked NBT's - W. Pine 16" S74°W 42 links, W. Pine 14" S75°E 25 links, and Cedar 8" N2°E 27 links.

Description of corner evidence found:

Recovered 6" cedar post, squared and scribed C-1/4 S2 C-1/4 S2, in fair condition. S2 C-1/4 Also a 2" iron pipe with aluminum cap stamped - This pipe set 1 link south of Lawrence's post. Recovered OBT's - Cedar stump 12" N8°E 13.5 links - scribed BT Ripco W. Pine stump 12" S19°E 25-1/4 links - refaced, no scribing visible W. Pine 14" (16") S75°E(S69°E) 25 links - scribed C-1/4 BT W. Pine 16" S74°W 42 links - now dead and down Cedar 8" (9") N2°E(N7°E) 27 links - scribed C-1/4 S2 NBT

Description of monument and accessories I established to perpetuate the original location of this corner.

As Lawrence set his post from Dorr's BT's, we extracted Ripco's pipe from the ground and replaced Lawrence's cedar post with it. Restamped Ripco's cap - T35N R10E

NBT - Cedar 8" N46°E 62.5 links - scribed C-1/4 BT

S2 C-1/4 Ripco

Dated at Rhineland, Wis., this 18th day of November, 1975.

Signature: Philip T. Hansen, Title: Registered Land Surveyor, Registration No. S-498 (County Surveyor, Registered Land Surveyor, or other duly authorized official)

Office of Register of Deeds, County of Oneida. I hereby certify that the within instrument was filed in this office for record on the 4th day of November, 1977 at 2:00 o'clock P.M.

Terrie Terage Kuehn (Register of Deeds)

By: Deputy

3510022020