

CERTIFIED LAND CORNER RESTORATION



Index No. **B-20**

State of Wisconsin

County of Oneida } ss.

I Philip T. Hansen, do hereby certify that on the 14th day of November, 1975, I found evidence of the NE-1/16 corner of Section 2 Township 35 North, Range 10 East, Fourth Principal Meridian, as described hereon; and that from this evidence I established a new monument and accessories as described hereon to perpetuate the original location of this corner.

Resident witnesses:
Glen Barker
Jim Claflin

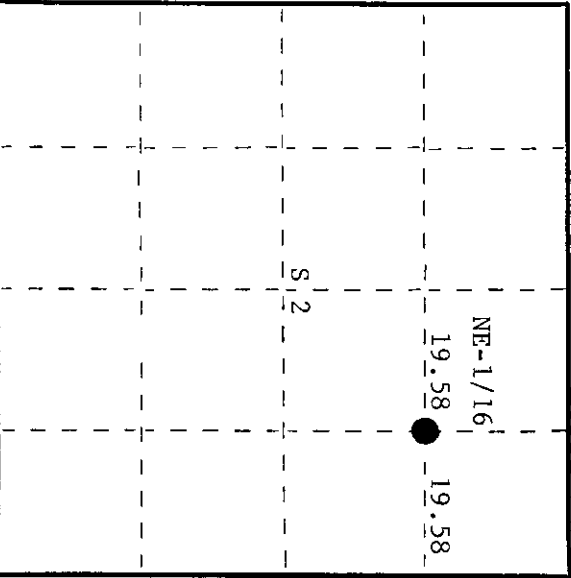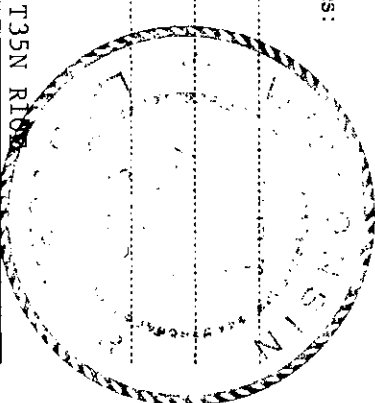

○ = Corner monument restored.

History of original corner establishment:

Original corner established by B.F. Dorr, County Surveyor, in 1896, from which maple 12" bears S36-1/2°E, 10-1/2 links. Corner recovered by H.C. Lawrence, Registered Land Surveyor, in 1954 during his retracement survey. Recovered stump of Dorr's BT. Set new 6" cedar post and marked NBT's - Hemlock 12" N72 1/2°W 41 links Maple 17" S56°W 37 links

Description of corner evidence found:

Recovered 6" cedar post, squared and scribed NE-1/16 S2, NE-1/16 S2, in fair condition.
Recovered OBT's - Hemlock 12"(10") N72 1/2°W(N68°W) 41 links - scribed NE-1/16 BT
Maple 7"(10") S56°W(S59°W) 37 links - scribed S2 BT

Description of monument and accessories I established to perpetuate the original location of this corner.

Replaced 6" cedar post with 1" OD iron pipe with 2" brass cap stamped - S498
Pipe projects 18" above ground. T35N R10E
NBT - Sugar 8" N45°E 45.5 links - scribed 1/16 BT
Pipe and BT's painted blue. NE-1/16 S2

CPI - 1975

Dated at Rhinelander, Wis., this 18th day of November, 1975.

Signature: *Philip T. Hansen* Title: Registered Land Surveyor Registration No. S-498
(County Surveyor, Registered Land Surveyor, or other duly authorized official)

Office of Register of Deeds, County of Oneida. I hereby certify that the within instrument was filed in this office for record on the 4th day of January, 1977 at 2:00 o'clock P.M.

Dana Verage Kreider
(Register of Deeds)

By: Deputy

3510023010